

GW 6458
 NW/SW, Sec. 8
 Elev. 115

Sunflower
0.61
2-26-80

MISSISSIPPI
 BOARD OF WATER COMMISSIONERS
 416 North State Street
 Jackson, Mississippi 39201

CODED

WATER WELL DRILLERS LOG

2/26 19*80* *Dyer* *Sum.*
 date well completed firm name county well located

LANDOWNER:
A. B. MC CARTY
Sunflower MS.
 (mailing address)

description of formations encountered	from	to
<i>Clay</i>	<i>0</i>	<i>28</i>
<i>Fair sand</i>	<i>28</i>	<i>35</i>
<i>Sand</i>	<i>35</i>	<i>48</i>
<i>Sand & Gravel</i>	<i>48</i>	<i>103</i>


WELL LOCATION:
 sec. *18* T *19* N R *3* E
2 miles *S* of *Sunflower*
 (distance) (direction) (nearest town)

WELL PURPOSE:
 (home, irrigation, municipal, industrial)

WELL COMPLETION DATA:

(1) diameter (inches) *12*
 (2) total depth (feet) *103'*
 (3) static water level (feet) *21'* below top of ground.
 (4) casing *Steel*, *103'*
 (material) (depth)
12" if telescope see back.
 (size)
 (5) screen *40'*, *63'*
 (length) (depth to top)
12", *Steel*
 (size) (material)
 (6) pump *40*, *2000*
 (HP) (yield gpm)
Diesel
 (type power)
 (7) electric log (yes or no)
 (organization running log)
 (8) how well bottom plugged *plate*


CODED

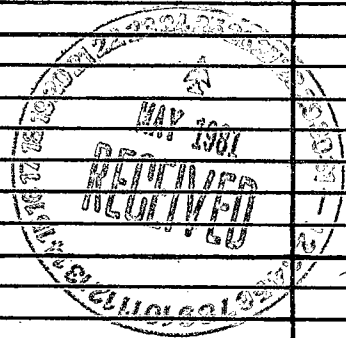

DRILLERS REMARKS:

If well telescopes please sketch and show depths.

GROUND LEVEL

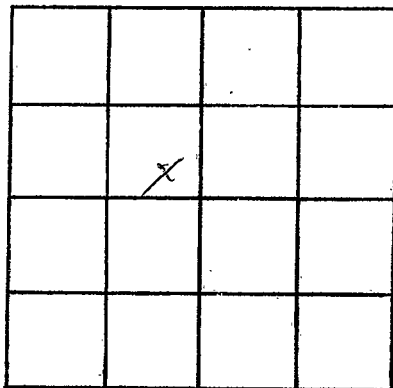

SECTION 18

Please indicate well location X.

ADDITIONAL INFORMATION

If more than one screen, show locations of each on sketch.