

Sun Flower
 062
 2-29-80

MISSISSIPPI
 BOARD OF WATER COMMISSIONERS
 416 North State Street
 Jackson, Mississippi 39201

CODED

WATER WELL DRILLERS LOG

2/29 1980 *Dye* Sun.
 date well completed firm name county well located

LANDOWNER: JOHN SIDNEY PARKER
 SUN FLOWER, Ms.
 (mailing address)


description of formations encountered	from	to
Clay	0	24
fine sand	24	38
sand	38	45
sand + gravel	45	123

WELL LOCATION:
 sec. 5 T 19 N R 3 E
 S W
 1 miles E of Sunflower
 (distance) (direction) (nearest town)

WELL PURPOSE:
 (home, irrigation, municipal, industrial)

WELL COMPLETION DATA:
 (1) diameter (inches) 12"
 (2) total depth (feet) 103'
 (3) static water level (feet) 21' below top of ground.
 (4) casing Steel 103' (material) (depth)
 12" if telescope see back. (size)
 (5) screen 40' 63' (length) (depth to top)
 12" Steel (size) (material)
 (6) pump 40 2000 (HP) (yield gpm)
 diesel (type power)
 (7) electric log (yes or no)
 (organization running log)
 (8) how well bottom plugged plate


CODED

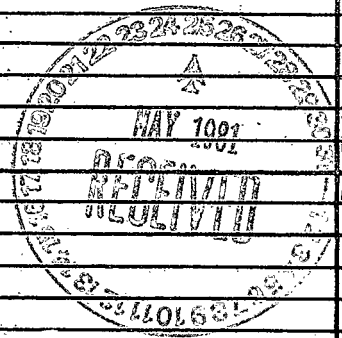

DRILLERS REMARKS:

If well telescopes please sketch and show depths.

GROUND LEVEL

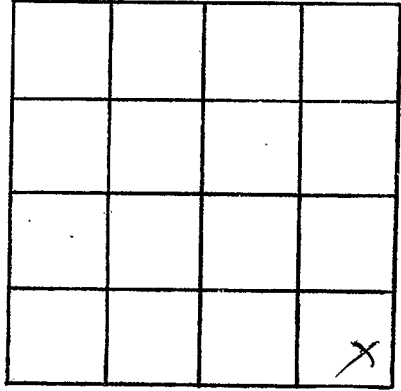

SECTION 5

Please indicate well location X.

ADDITIONAL INFORMATION

If more than one screen, show locations of each on sketch.