

Bureau of Land and Water Resources

Southport Mall

P.O. Box 10631

Jackson, Mississippi 39209

WATER WELL DRILLERS LOG

CODED

3311

*Sunflower*

*Q.64*

*11-26-80*

*11-26* 19 *80*

*Dyer*

*Sunflower*

date well completed

firm name

county well located

LANDOWNER:

*JOHN S. PARIER*

description of formations encountered

from

to

*Sunflower MS.*  
(mailing address) *38778*

*0-45' top sub clay*  
*45-93' sand & gravel*

WELL LOCATION:

sec *5* T *19* N R *3* E  
*S* *W*  
*1* miles *S* of *Sunflower*  
(distance) (direction) (nearest town)


WELL PURPOSE:

(home, irrigation, municipal, industrial)


WELL COMPLETION DATA:

- (1) diameter (inches) *10"*
- (2) total depth (feet) *93'*
- (3) static water level (feet) *20'* below top of ground.
- (4) casing *Steel* *93'*  
(material) (depth)  
*10"*  
(size) If telescope see back.
- (5) screen *40'* *53'*  
(length) (depth to top)  
*10"* *Steel*  
(size) (material)
- (6) pump *25* *1200*  
(HP) (yield gpm)  
*electric*  
(type power)
- (7) electric log (yes or no)
- (organization running log)
- (8) how well bottom plugged *plate*

CODED

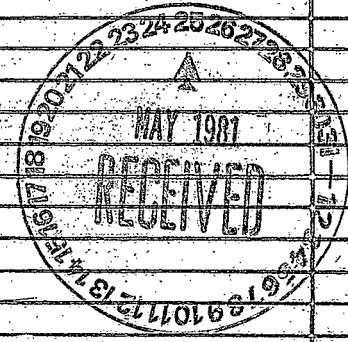

DRILLERS REMARKS:

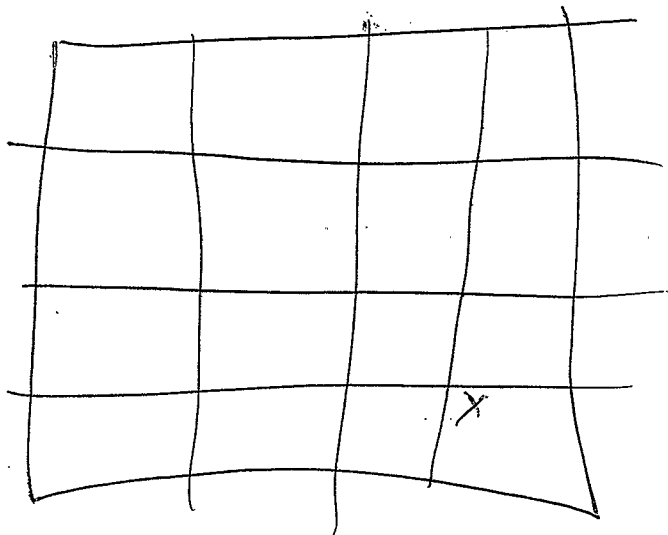

See 5