

SUNFLOWER  
 66  
 6-5-81

MISSISSIPPI DEPARTMENT OF NATURAL RESOURCES  
 Bureau of Land and Water Resources  
 Southport Mall  
 P.O. Box 10631  
 Jackson, Mississippi 39209  
**WATER WELL DRILLERS LOG**

**CODED**

6-5-81 19 *Super well* *San N Flower*  
 date well completed firm name county well located

LANDOWNER: *A. B. McCarty*

description of formations encountered:	from	to
<i>Clay</i>	<i>0</i>	<i>60</i>
<i>Sand</i>	<i>60</i>	<i>70</i>
<i>Sand + Gravel</i>	<i>70</i>	<i>103</i>

*Rulerville, Ms*  
 (mailing address)

WELL LOCATION:  
 sec. *18* T *19* N R. *3* E  
*3* miles *S* of *Sunflower*  
 (distance) (direction) (nearest town)

WELL PURPOSE:  
 (home, irrigation, municipal, industrial)

- WELL COMPLETION DATA:
- (1) diameter (inches) *12*
  - (2) total depth (feet) *103*
  - (3) static water level (feet) *22'* below top of ground.
  - (4) casing *Steel*, (depth) *12* if telescope see back. (size)
  - (5) screen *20*, *83'* (length) (depth to top) *Steel* (size) (material)
  - (6) pump *30*, *1200* (HP) (yield gpm) *Wessell* (type power)
  - (7) electric log (yes or no)

**CODED**

DEPT. OF NATURAL RESOURCES  
 BUREAU OF LAND & WATER RESOURCES

JUN 15 1981


**RECEIVED**

(organization running log)  
 (8) how well bottom plugged *Shale*

DRILLERS REMARKS:

If well telescopes please sketch and show depths.

GROUND LEVEL

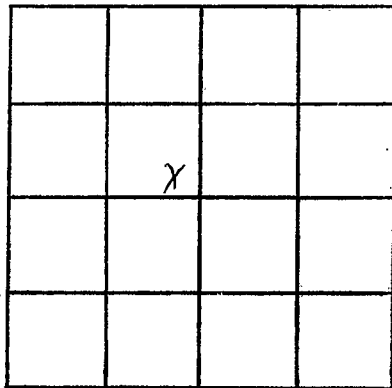

SECTION 18

Please indicate well location X.

ADDITIONAL INFORMATION

If more than one screen,  
show locations of each on sketch.