

MISSISSIPPI DEPARTMENT OF NATURAL RESOURCES

Bureau of Land and Water Resources

Southport Mall

P.O. Box 10631

CODED

Jackson, Mississippi 39209

WATER WELL DRILLERS LOG

Shuford
Q 67
4-16-81

date well completed April 16, 1981 Larry's well pump Shuford
 name county well located

LANDOWNER: <u>Larry Hall</u>	description of formations encountered	from	to
<u>Indianapolis Miss</u> (mailing address)	<u>CLAY</u>	<u>0</u>	<u>50</u>
	<u>FINE SAND</u>	<u>50</u>	<u>75</u>
	<u>COURSE SAND</u>	<u>70</u>	<u>116</u>

WELL LOCATION:
 sec. 9 T 19 N R 3 E
3 miles E of Shuford
 (distance) (direction) (nearest town)

WELL PURPOSE:
 (home, irrigation, municipal, industrial)

WELL COMPLETION DATA:

(1) diameter (inches) 16"

(2) total depth (feet) 116'

(3) static water level (feet) 20 below above top of ground.

(4) casing Steel, 76'
 (material) (depth)
 (size) if telescope see back.


(5) screen 40', 76'
 (length) (depth to top)
16", Steel
 (size) (material)

(6) pump 60, 3000
 (HP) (yield gpm)
 (type power)

(7) electric log No
 (yes or no)
 (organization running log)

(8) how well bottom plugged Steel Plate


CODED

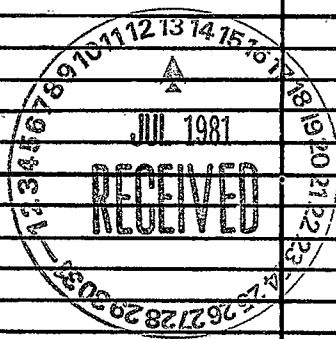

DRILLERS REMARKS:

If well telescopes please sketch and show depths.

GROUND LEVEL

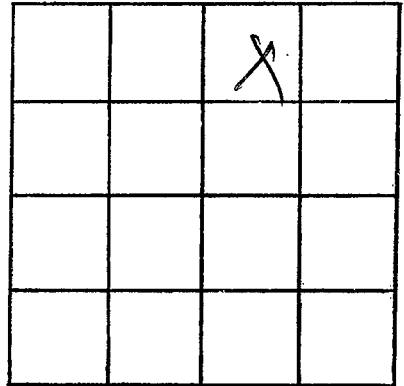

SECTION 9

Please indicate well location X.

ADDITIONAL INFORMATION

If more than one screen,
show locations of each on sketch.

9