

MISSISSIPPI DEPARTMENT OF NATURAL RESOURCES

Bureau of Land and Water Resources

Southport Mall

P.O. Box 10631

Jackson, Mississippi 39209

WATER WELL DRILLERS LOG

Sunflower
Q68
5-13-81

date well completed May 13 1981 firm name Larry's Well & Pump county well located Sunflower

LANDOWNER: <u>W. Timbs</u>	description of formations encountered		from	to
<u>Moorehead mo</u> (mailing address)	Clay		0	40
	Fine sand		40	70
	Coarse sand		70	116
WELL LOCATION: sec. <u>27</u> T. <u>19</u> N. R. <u>3</u> E S W <u>3</u> miles <u>N</u> of <u>Moorehead</u> (distance) (direction) (nearest town)				
WELL PURPOSE: (home, irrigation, municipal, industrial)				
WELL COMPLETION DATA:				
(1) diameter (inches) <u>16"</u>				
(2) total depth (feet) <u>116'</u>				
(3) static water level (feet) <u>28</u> below above top of ground.				
(4) casing <u>Steel</u> , <u>76'</u> (material) (depth)				
(size) If telescope see back.				
(5) screen <u>40</u> , <u>76'</u> (length) (depth to top)				
<u>16"</u> , <u>Steel</u> (size) (material)				
(6) pump _____ (HP) (yield gpm)				
(type power)				
(7) electric log <u>NO</u> (yes or no)				
(organization running log)				
(8) how well bottom plugged <u>Steel Plate</u>				

WELLED


CODED

DEPT. OF NATURAL RESOURCES
 BUREAU OF LAND & WATER RESOURCES
 JUL 16 1981
 RECEIVED

DRILLERS REMARKS:

If well telescopes please sketch and show depths.

GROUND LEVEL

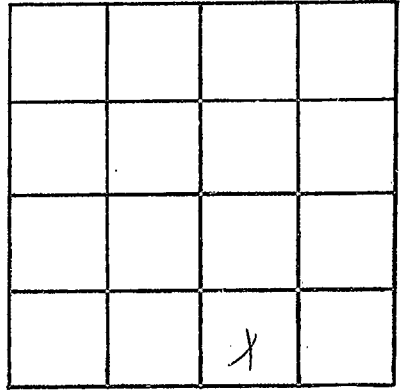

SECTION 27

Please indicate well location X.

ADDITIONAL INFORMATION

If more than one screen,
show locations of each on sketch.