

MISSISSIPPI DEPARTMENT OF NATURAL RESOURCES

Bureau of Land and Water Resources

Southport Mall

P.O. Box 10631

Jackson, Mississippi 39209

WATER WELL DRILLERS LOG

CODED

SUNFLOWER
 69
 7-8-81

GW 6477
 SW/SW, Sec. 18
 Elev. 114

7/8/81
 date well completed

Superior + Dring
 firm name

Sunflower
 county well located

LANDOWNER: TR Seavel

description of formations encountered

from to

Sunflower, Ms.
 (mailing address)

Clay	13	23
Clay	23	33
san	33	43
san	43	53
grault	53	63
grault	63	73
san & grault	73	83
sand grault	83	93
grault	93	103
grault & clay	103	110

WELL LOCATION:

sec. 18 T 19 N R 3 E
2 miles S of Sunflower
 (distance) (direction) (nearest town)

WELL PURPOSE:

(home, irrigation, municipal, industrial)

WELL COMPLETION DATA:


- (1) diameter (inches) 16
- (2) total depth (feet) 110'
- (3) static water level (feet) 20' below top of ground.
- (4) casing Steel 70'
 (material) (depth)
16 if telescope see back.
 (size)
- (5) screen 40 70'
 (length) (depth to top)
~~16~~ 16 Steel
 (size) (material)
- (6) pump 60 3000
 (HP) (yield gpm)
Diesel
 (type power)
- (7) electric log No
 (yes or no)

(organization running log)

(8) how well bottom plugged Plate

DRILLERS REMARKS:

CODED

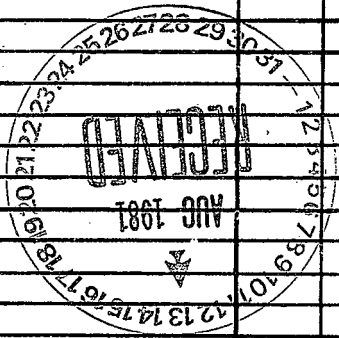

If well telescopes please sketch and show depths.

GROUND LEVEL

			X

SECTION 18

Please indicate well location X.

ADDITIONAL INFORMATION

If more than one screen, show locations of each on sketch.