

MISSISSIPPI DEPARTMENT OF NATURAL RESOURCES

Bureau of Land and Water Resources

Southport Mall

P.O. Box 10631

Jackson, Mississippi 39209

WATER WELL DRILLERS LOG

CODED

501
φ 70
8-6-B1

6W 6457
 SW/SW, Sec. 8
 Elev. 116

8/6/81
 date/well completed

Super Wells & Svc
 firm name

Jefferson
 county well located

LANDOWNER: A. B. McCarty
McDeane Corp.

description of formations encountered

from

to

Merriam, MS
 (mailing address)

Clay	0	38
Fine Sand	38	56
Sand	56	64
Sand & Gravel	64	110

WELL LOCATION:

sec. 18 T 19 N R 3 E
2 miles S of Superior
 (distance) (direction) (nearest town)

WELL PURPOSE:

(home, irrigation) municipal, industrial

WELL COMPLETION DATA:


- (1) diameter (inches) 16
- (2) total depth (feet) 1101
- (3) static water level (feet) 20 below above top of ground.
- (4) casing Steel, 70',
 (material) (depth)
16 if telescope see back.
 (size)
- (5) screen 40, 70'
 (length) (depth to top)
16, Steel
 (size) (material)
- (6) pump 40, 2000
 (HP) (yield gpm)
Electric
 (type power)
- (7) electric log NO
 (yes or no)

(organization running log)

(8) how well bottom plugged Plate

DRILLERS REMARKS:


CODED

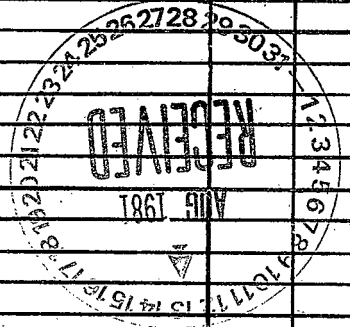

DRILLERS REMARKS:

If well telescopes please sketch and show depths.

GROUND LEVEL

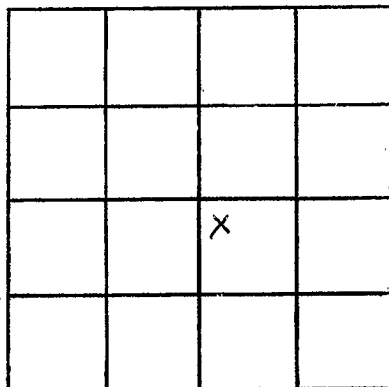

SECTION 18

Please indicate well location X.

ADDITIONAL INFORMATION

If more than one screen,
show locations of each on sketch.