

MISSISSIPPI DEPARTMENT OF NATURAL RESOURCES

Bureau of Land and Water Resources

Southport Mall

P.O. Box 10631

Jackson, Mississippi 39209

WATER WELL DRILLERS LOG

CODED

Sunflower
 Ø 71
 7-9-81

7/9/81
 date well completed

Superwell + Jurgens
 firm name

Sunflower
 county well located

LANDOWNER: R. D. Bearden + Sons

description of formations encountered

from

to

Isola, Ms
 (mailing address)

Clay	0	18
Fine sand	18	38
Sand	38	54
Sand + gravel	54	113

WELL LOCATION:

sec. 17 T. 19 N. R. 3 E. (W)
2 miles S of Sunflower
 (distance) (direction) (nearest town)

WELL PURPOSE:
 (home, irrigation, municipal, industrial)

CODED


WELL COMPLETION DATA:

- (1) diameter (inches) 16
- (2) total depth (feet) 113'
- (3) static water level (feet) 22' below top of ground.
- (4) casing Steel 73'
 (material) (depth)
16 if telescope see back.
 (size)
- (5) screen 40', 73'
 (length) (depth to top)
16", Steel
 (size) (material)
- (6) pump 60 3000
 (HP) (yield gpm)
Electric
 (type power)
- (7) electric log No
 (yes or no)

(organization running log)


(8) how well bottom plugged Plato

DRILLERS REMARKS:

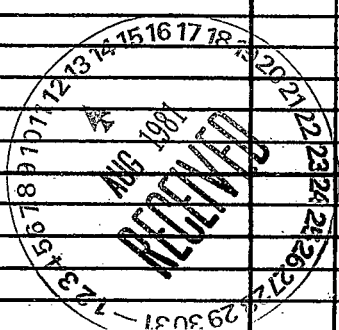

If well telescopes please sketch and show depths.

GROUND LEVEL

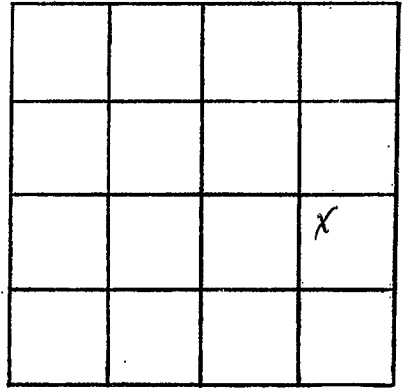

SECTION 17

Please indicate well location X.

ADDITIONAL INFORMATION

If more than one screen,
show locations of each on sketch.