

MISSISSIPPI DEPARTMENT OF NATURAL RESOURCES

Bureau of Land and Water Resources

Southport Mall

P.O. Box 10631

Jackson, Mississippi 39209

WATER WELL DRILLERS LOG

CODED

Sunflower  
Ø 73  
9-24-81

GW 6475  
 NW/ NW, Sec. 18  
 Elev. 116

9-24  
 date well completed


1981 Dyer Well + Irrigation  
 firm name

Sunflower  
 county well located

LANDOWNER: <u>McLeavelle Corp.</u>	description of formations encountered	from	to
<u>Taverness, Miss.</u> (mailing address)	<u>Clay</u>	<u>0</u>	<u>25</u>
WELL LOCATION: sec. <u>18</u> T <u>19</u> N R <u>3</u> E S <u>5</u> W <u>1</u>	<u>find sand</u>	<u>25</u>	<u>40</u>
<u>2</u> miles <u>S</u> of <u>Sunflower</u> (distance) (direction) (nearest town)	<u>sand + Gravel</u>	<u>110</u>	<u>113</u>
WELL PURPOSE: <u>Irrigation</u> (home, <u>irrigation</u> , municipal, industrial)	CODED		
WELL COMPLETION DATA:			
(1) diameter (inches) <u>16"</u>			
(2) total depth (feet) <u>113'</u>			
(3) static water level (feet) <u>22'</u> below top of ground.			
(4) casing <u>Steel</u> , <u>73'</u> (material) (depth)			
<u>16"</u> if telescope see back. (size)			
(5) screen <u>40'</u> , <u>73'</u> (length) (depth to top)			
<u>16"</u> , <u>Steel</u> (size) (material)			
(6) pump <u>40</u> <u>2000</u> (HP) (yield gpm)			
<u>electric</u> (type power)			
(7) electric log <u>No</u> (yes or no)			
<u>NONE</u> (organization running log)			
(8) how well bottom plugged <u>Plate</u>			
DRILLERS REMARKS:	DEPT. OF NATURAL RESOURCES BUREAU OF LAND & WATER RESOURCES OCT - 1 1981 RECEIVED		

If well telescopes please sketch and show depths.

GROUND LEVEL

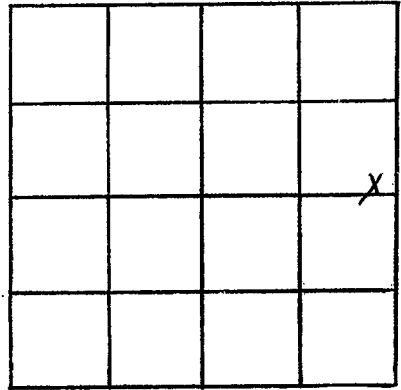

SECTION 18

Please indicate well location X.

ADDITIONAL INFORMATION

If more than one screen,  
show locations of each on sketch.