

MISSISSIPPI DEPARTMENT OF NATURAL RESOURCES

Bureau of Land and Water Resources

Southport Mall

P.O. Box 10631

Jackson, Mississippi 39209

WATER WELL DRILLERS LOG

CODED

Senflower
D 84
 5/20/82

5/20 1982
 date well completed

Larris well pump
 firm name

Senflower
 county/well located

LANDOWNER:

Steve Mitchell

description of formations encountered

from

to

Atta Bern mo
 (mailing address)

<i>slay</i>	0	30
<i>steel S</i>	30	60
<i>same S + gravel</i>	60	116

WELL LOCATION:

sec. 17 T 19 N R 3 E
 S W
3 miles north of moreland
 (distance) (direction) (nearest town)

WELL PURPOSE:

(home, irrigation, municipal, industrial)

WELL COMPLETION DATA:

- (1) diameter (inches) 16"
- (2) total depth (feet) 116'
- (3) static water level (feet) 26 below above top of ground.
- (4) casing Steel, 76'
(material) (depth)
(size) if telescope see back.
- (5) screen 40, 76'
(length) (depth to top)
16", Steel
(size) (material)
- (6) pump 60 3000
(HP) (yield gpm)
Gas
(type power)
- (7) electric log NO
(yes or no)

(organization running log)

(8) how well bottom plugged Steel Plate

DRILLERS REMARKS:


DEPT. OF NATURAL RESOURCES
 BUREAU OF LAND & WATER RESOURCES

SEP 15 1982

RECEIVED

If well telescopes please sketch and show depths.

GROUND LEVEL

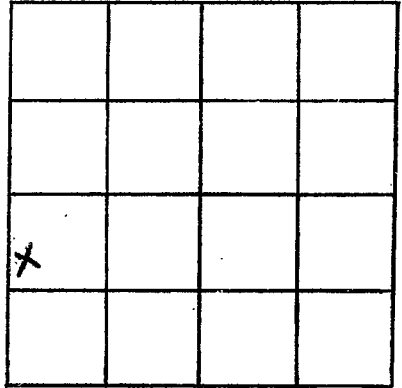

SECTION 17

Please indicate well location X.

ADDITIONAL INFORMATION

If more than one screen, show locations of each on sketch.