

MISSISSIPPI DEPARTMENT OF NATURAL RESOURCES

Bureau of Land and Water Resources

Southport Mall

P.O. Box 10631

Jackson, Mississippi 39209

CODED

WATER WELL DRILLERS LOG

*Surflower*  
 085  
 611182

6-11-82 *Super Well* *Surflower*  
 date well completed firm name county well located


LANDOWNER: <i>James Bradshaw</i>	description of formations encountered	from	to
(mailing address)	<i>Clay</i>	0	28
WELL LOCATION: sec <u>3</u> T <u>19</u> N S R <u>3</u> E <u>4</u> miles <u>E</u> of <u>Surflower</u> (distance) (direction) (nearest town)	<i>Sand</i>	28	<del>37</del>
WELL PURPOSE: (home, irrigation, municipal, industrial)	<i>Sand &amp; Gravel</i>	44	103
WELL COMPLETION DATA:			
(1) diameter (inches) <u>16</u>			
(2) total depth (feet) <u>103</u>			
(3) static water level (feet) <u>15</u> below above top of ground.			
(4) casing <u>Steel</u> <u>90</u> <u>3</u> (material) (depth)			
<u>16</u> if telescope see back. (size)			
(5) screen <u>40</u> <u>63</u> (length) (depth to top)			
<u>16</u> <u>Mild Steel</u> (size) (material)			
(6) pump <u>60</u> <u>3,000</u> (HP) (yield gpm)			
<u> diesel</u> (type power)			
(7) electric log <u>No</u> (yes or no)			
(organization running log)			
(8) how well bottom plugged <u>Plate</u>			
DRILLERS REMARKS:			

DEPT. OF NATURAL RESOURCES  
 BUREAU OF LAND & WATER RESOURCES

SEP 30 1982  
 RECEIVED

If well telescopes please sketch and show depths.

GROUND LEVEL

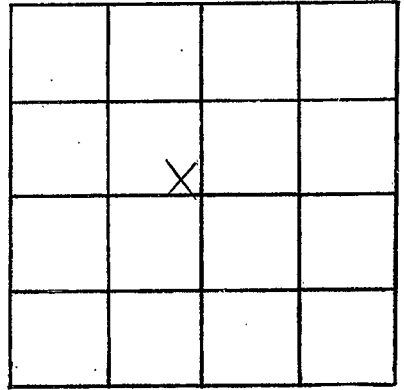

SECTION 3

Please indicate well location X.

ADDITIONAL INFORMATION

If more than one screen,  
show locations of each on sketch.