

MISSISSIPPI DEPARTMENT OF NATURAL RESOURCES

Bureau of Land and Water Resources

Southport Mall

P.O. Box 10631

Jackson, Mississippi 39209

WATER WELL DRILLERS LOG

CODED
11

SCYNFLOWER
D 86
41.83

19 1983 date well completed
Dyer Wells Inc firm name
Jefferson Co county well located

LANDOWNER: W. E. Austin
Indianola
(mailing address)

description of formations encountered	from	to
<u>Clay</u>	<u>0</u>	<u>30</u>
<u>fine sand</u>	<u>30</u>	<u>38</u>
<u>sand</u>	<u>38</u>	<u>42</u>
<u>sand & gravel</u>	<u>42</u>	<u>113</u>

WELL LOCATION:
sec. R 12 T 10 S R 3 E
5 miles N of MOORHEAD
(distance) (direction) (nearest town)

WELL PURPOSE:
(home, irrigation, municipal, industrial)

WELL COMPLETION DATA:

(1) diameter (inches) 16

(2) total depth (feet) 113

(3) static water level (feet) 30 below above top of ground.

(4) casing Steel, 73 (material) (depth)
(size) if telescope see back.

(5) screen 40' (length) (depth to top)
16" (size) steel (material)

(6) pump 60 (HP) 3000 (yield gpm)
diesel (type power)

(7) electric log no (yes or no)
(organization running log)

(8) how well bottom plugged plate

CODED

DEPT. OF NATURAL RESOURCES
BUREAU OF LAND & WATER RESOURCES


MAY 9 - 1983

RECEIVED

DRILLERS REMARKS:

If well telescopes please
sketch and show depths.

GROUND LEVEL

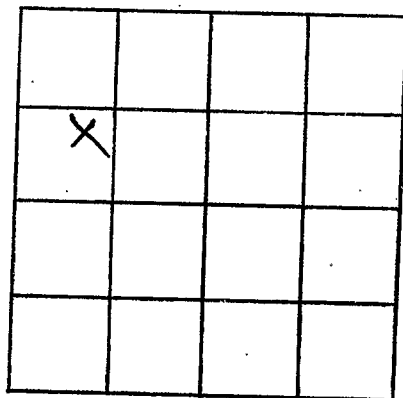

SECTION 12

Please indicate well location X.

ADDITIONAL INFORMATION

If more than one screen,
show locations of each on sketch.