

MISSISSIPPI DEPARTMENT OF NATURAL RESOURCES

Bureau of Land and Water Resources

Southport Mall

P.O. Box 10631

Jackson, Mississippi 39209

WATER WELL DRILLERS LOG

CODED

SUNFLOWER
Q 87
7/15/83

July 15, 1983 Dyer Well + Irrigation Sunflower
date well completed firm name county well located

LANDOWNER: Fitts Brothers
Moorhead, Miss.
(mailing address)
WELL LOCATION:
sec. 36 T. 19 N. R. 3 E. W
4 miles N. East of Moorhead
(distance) (direction) (nearest town)

description of formations encountered	from	to
Clay	0	28
Finest Sand	28	48
Sand	48	58
Sand + Gravel	58	113

WELL PURPOSE: Irrigation
(home, irrigation, municipal, industrial)

WELL COMPLETION DATA:

(1) diameter (inches) 16

(2) total depth (feet) 113'

(3) static water level (feet) 24' below above top of ground.

(4) casing Steel 73'
(material) (depth)
16" if telescope see back.
(size)

(5) screen 40 73'
(length) (depth to top)
16" Mild Steel
(size) (material)

(6) pump 60 3,000
(HP) (yield gpm)
Diesel
(type power)

(7) electric log no
(yes or no)
(organization running log)

(8) how well bottom plugged Plate

CODED

DEPT. OF NATURAL RESOURCES
BUREAU OF LAND & WATER RESOURCES


DEC 7 1983

RECEIVED

DRILLERS REMARKS:

If well telescopes please sketch and show depths.

GROUND LEVEL

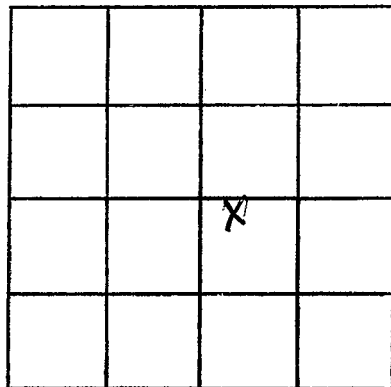

SECTION 36

Please indicate well location X.

ADDITIONAL INFORMATION

If more than one screen,
show locations of each on sketch.