

MISSISSIPPI DEPARTMENT OF NATURAL RESOURCES

Bureau of Land and Water Resources

Southport Mall

P.O. Box 10631

Jackson, Mississippi 39209

WATER WELL DRILLERS LOG

CODED

SUNFLOWER

Q 88

8/16/83

Aug. 16

1983

Dyer Well + Irrigation

Sunflower

date well completed

firm name

county well located

LANDOWNER: Charles + Wayne Fitts

description of formations encountered

from

to

Moorehead, Miss

(mailing address)

Clay
Fine Sand
Sand
Sand + Gravel

0 35
35 40
40 48
48 110

WELL LOCATION:

sec 34 T 19 N R 3 E
S W
5 miles N.E. of Moorehead
(distance) (direction) (nearest town)

WELL PURPOSE: Irrigation
(home, irrigation, municipal, industrial)

CODED

WELL COMPLETION DATA:

- (1) diameter (inches) 16"
- (2) total depth (feet) 110'
- (3) static water level (feet) 24' below top of ground.
- (4) casing Steel 70' (material) (depth)
16" If telescope see back. (size)
- (5) screen 40 70' (length) (depth to top)
16" Mild Steel (size) (material)
- (6) pump 600 3,000 (HP) (yield gpm)
Diesel (type power)
- (7) electric log No (yes or no)

(organization running log)

(8) how well bottom plugged Plate

DEPT. OF NATURAL RESOURCES
BUREAU OF LAND & WATER RESOURCES


DEC - 7 1983

RECEIVED

DRILLERS REMARKS:

If well telescopes please sketch and show depths.

GROUND LEVEL

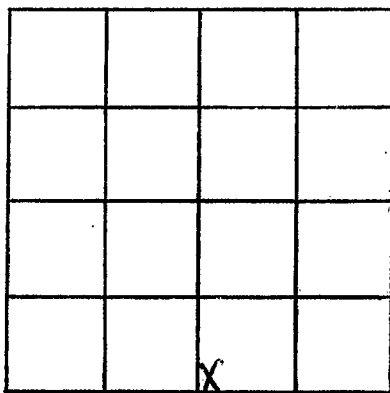

SECTION 34

Please indicate well location X.

ADDITIONAL INFORMATION

If more than one screen,
show locations of each on sketch.