

MISSISSIPPI DEPARTMENT OF NATURAL RESOURCES

Bureau of Land and Water Resources

Southport Mall

P.O. Box 10631

Jackson, Mississippi 39209

WATER WELL DRILLERS LOG

CODED

SUNFLOWER
290
8/25/83

Aug. 25, 1983 Dyer Well + Irrigation Sunflower
 date well completed firm name county well located

| LANDOWNER: <u>W.E. Austin</u> | description of formations encountered | from | to |
|---|---------------------------------------|------------|------------|
| <u>Indianola, Miss.</u> (mailing address) | <u>Clay</u> | <u>0</u> | <u>41</u> |
| | <u>Sand & gravel</u> | <u>41</u> | <u>99</u> |
| | <u>fine sand</u> | <u>99</u> | <u>104</u> |
| | <u>sand & gravel</u> | <u>104</u> | <u>113</u> |
| WELL LOCATION: sec. <u>1</u> T. <u>19</u> N. R. <u>3</u> E. <u>5</u> miles <u>SE</u> of <u>Sunflower</u> (distance) (direction) (nearest town) | | | |
| WELL PURPOSE: <u>Irrigation</u> (home, irrigation, municipal, industrial) | | | |
| WELL COMPLETION DATA: | | | |
| (1) diameter (inches) <u>16"</u> | | | |
| (2) total depth (feet) <u>113'</u> | | | |
| (3) static water level (feet) <u>24'</u> below top of ground. | | | |
| (4) casing <u>Steel</u> , <u>73'</u> (material) (depth) | | | |
| <u>16</u> if telescope see back. (size) | | | |
| (5) screen <u>40"</u> , <u>73'</u> (length) (depth to top) | | | |
| <u>16</u> , <u>Mild Steel</u> (size) (material) | | | |
| (6) pump <u>600</u> <u>3000</u> (HP) (yield gpm) | | | |
| <u>Electric</u> (type power) | | | |
| (7) electric log <u>No</u> (yes or no) | | | |
| (organization running log) | | | |
| (8) how well bottom plugged <u>Plate</u> | | | |
| DRILLERS REMARKS: | | | |

CODED


DEPT. OF NATURAL RESOURCES
 BUREAU OF LAND & WATER RESOURCES

DEC - 7 1983

RECEIVED

If well telescopes please sketch and show depths.

GROUND LEVEL

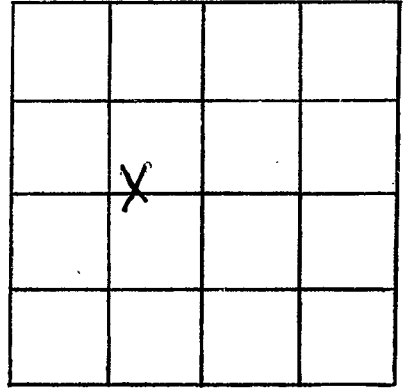

SECTION 1

Please indicate well location X.

ADDITIONAL INFORMATION

If more than one screen,
show locations of each on sketch.