

MISSISSIPPI DEPARTMENT OF NATURAL RESOURCES

Bureau of Land and Water Resources

Southport Mall

P.O. Box 10631

Jackson, Mississippi 39209

WATER WELL DRILLERS LOG

CODED

SUNFLOWER
 291
 8/26/83

Aug. 26, 1983 Dyer Well + Irrigation Sunflower
 date well completed firm name county well located

LANDOWNER: W. E. Austin
Indianola, Miss.
 (mailing address)

description of formations encountered	from	to
Clay	0	230
Mudstone	18	75
Sand + Gravel	30	108

WELL LOCATION:
 sec. 1 T. 19N R. 3E
5 miles SE of Sunflower
 (distance) (direction) (nearest town)

CODED		
-------	--	--

WELL PURPOSE: Irrigation
 (home, irrigation, municipal, industrial)

WELL COMPLETION DATA:

(1) diameter (inches) 16"

(2) total depth (feet) 108'

(3) static water level (feet) 23' below top of ground.

(4) casing Steel 108'
 (material) (depth)
16" If telescope see back.
 (size)

(5) screen 40' 108'
 (length) (depth to top)
16" Mild Steel
 (size) (material)

(6) pump 600 3,000
 (HP) (yield gpm)
Electric
 (type power)

(7) electric log No
 (yes or no)

(8) how well bottom plugged Plate
 (organization running log)

CODED		
-------	--	--

DRILLERS REMARKS:


DEPT. OF NATURAL RESOURCES
 BUREAU OF LAND AND WATER RESOURCES

DEC - 7 1983

RECEIVED

If well telescopes please sketch and show depths.

GROUND LEVEL

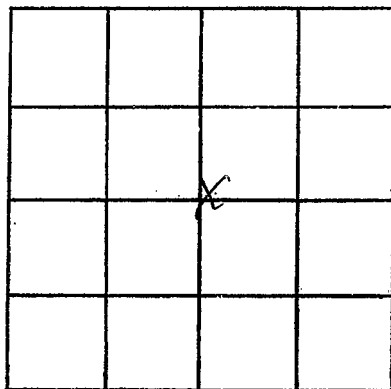

SECTION 1

Please indicate well location X.

ADDITIONAL INFORMATION

If more than one screen,
show locations of each on sketch.