

MISSISSIPPI DEPARTMENT OF NATURAL RESOURCES

Bureau of Land and Water Resources

Southport Mall

P.O. Box 10631

Jackson, Mississippi 39209

WATER WELL DRILLERS LOG

CODED

SUNFLOWER
892
9/6/83

Sept 6, 1983 Dyer Well + Irrigation Sunflower
 date well completed firm name county well located

LANDOWNER: <u>W.E. Austin</u>	description of formations encountered	from	to
<u>Indianola, Miss.</u> (mailing address)	<u>Clay</u> <u>Sand + Gravel</u>	<u>0</u> <u>30</u>	<u>30</u> <u>108</u>
WELL LOCATION: sec. <u>1</u> T <u>19</u> (N) S <u>5</u> R <u>3</u> E W <u>5</u> <u>5</u> miles <u>SE</u> of <u>Sunflower</u> (distance) (direction) (nearest town)	CODED		
WELL PURPOSE: <u>irrigation</u> (home, irrigation, municipal, industrial)			
WELL COMPLETION DATA:			
(1) diameter (inches) <u>16"</u>			
(2) total depth (feet) <u>108'</u>			
(3) static water level (feet) <u>24'</u> below top of ground.			
(4) casing <u>Steel</u> , <u>68'</u> (material) (depth)			
<u>16"</u> if telescope see back. (size)			
(5) screen <u>40'</u> , <u>68'</u> (length) (depth to top)			
<u>16"</u> , <u>Mild Steel</u> (size) (material)			
(6) pump <u>60</u> , <u>3,000</u> (HP) (yield gpm)			
<u>Electric</u> (type power)			
(7) electric log <u>No</u> (yes or no)			
<u>(organization running log)</u>			
(8) how well bottom plugged <u>None</u>			

DEPT. OF NATURAL RESOURCES
BUREAU OF LAND & WATER RESOURCES


DEC - 7 1983

RECEIVED

DRILLERS REMARKS:

If well telescopes please sketch and show depths.

GROUND LEVEL

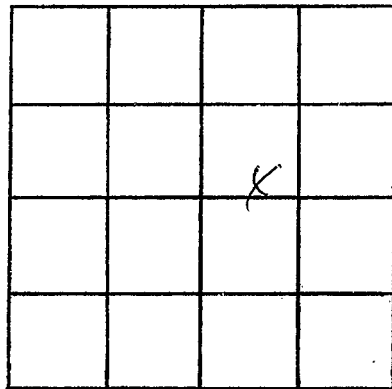

SECTION 1

Please indicate well location X.

ADDITIONAL INFORMATION

If more than one screen,
show locations of each on sketch.