

MISSISSIPPI DEPARTMENT OF NATURAL RESOURCES

Bureau of Land and Water Resources

Southport Mall

P.O. Box 10631

Jackson, Mississippi 39209

WATER WELL DRILLERS LOG

CODED

39 N. Lower
Q93
9/8/83

Sept. 8, 1983 Dyer Well + Irrigation Sunflower
 date well completed firm name county well located

LANDOWNER: W.E. Austin

description of formations encountered	from	to
---------------------------------------	------	----

Indianole, Miss.
 (mailing address)

<u>Clay</u>	<u>0</u>	<u>30</u>
<u>Sand & Gravel</u>	<u>30</u>	<u>65</u>
<u>Fine Sand</u>	<u>65</u>	<u>80</u>
<u>Sand & Gravel</u>	<u>80</u>	<u>123</u>

WELL LOCATION:
 sec. 1 T. 19(N) R. 3
5 miles SE of Sunflower
 (distance) (direction) (nearest town)

WELL PURPOSE: Irrigation
 (home, irrigation, municipal, industrial)

CODED

WELL COMPLETION DATA:

- (1) diameter (inches) 16"
- (2) total depth (feet) 123'
- (3) static water level (feet) 24' below top of ground.
- (4) casing Steel, 83'
 (material) (depth)
16" if telescope see back.
 (size)
- (5) screen 40', 83'
 (length) (depth to top)
16", Mild Steel
 (size) (material)
- (6) pump 60, 3,000
 (HP) (yield gpm)
Electric
 (type power)
- (7) electric log No
 (yes or no)
 (organization running log)
- (8) how well bottom plugged Plate

DEPT. OF NATURAL RESOURCES
 BUREAU OF LAND & WATER RESOURCES


DEC - 7 1983

RECEIVED

DRILLERS REMARKS:

If well telescopes please sketch and show depths.

GROUND LEVEL

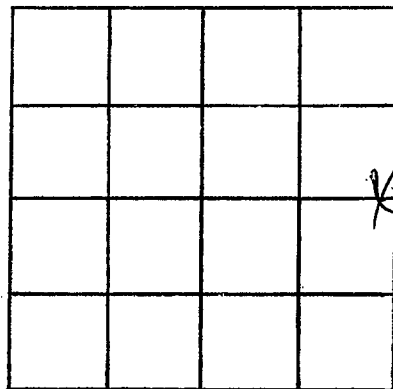

SECTION 1

Please indicate well location X.

ADDITIONAL INFORMATION

If more than one screen,
show locations of each on sketch.