

SUNFLOWER
 D 94
 9-16-83
 Elog #78

MISSISSIPPI
 BOARD OF WATER COMMISSIONERS
 416 North State Street
 Jackson, Mississippi 39201
WATER WELL DRILLERS LOG

CODED

16 September 19 83 Herndon Well & Supply, Inc. Sunflower
 date well completed firm name county well located

LANDOWNER: Jesco, Inc.	description of formations encountered	from	to
P. O. Box 789, Fulton, MS			
For: Grain Fed Fish Sunflower, (mailing address) MS	Brown Clay	0	30
WELL LOCATION: sec 3 T 19 N R 3 XXX W x8 2 miles East of Sunflower (distance) (direction) (nearest town)	Brown Sand	30	80
WELL PURPOSE: industrial (home, irrigation, municipal, industrial)	Fine Gravel	80	130
WELL COMPLETION DATA:	Sand & Blue Clay	130	320
(1) diameter (inches) 10 x 6"	Blue Clay	320	325
(2) total depth (feet) 712'	Blue Sand	325	370
(3) static water level (feet) 20 below top of ground. above XXXX	Blue Clay	370	450
(4) casing Steel 500' (material) (depth) 10" if telescope see back. (size)	Sand	450	500
(5) screen 63' 472' (length) (depth to top) 6" S. S. Ribbed (size) (material)	Sand & Blue	500	550
(6) pump 40 500 (HP) (yield gpm) electric (type power)	Blue Clay	550	580
(7) electric log yes (yes or no) MS Bureau of Geology (organization running log)	Sand	580	600
(8) how well bottom plugged 6" BWV	Clay	600	604
DRILLERS REMARKS:	Sand	604	640
	Clay	640	645
	Sand	645	675
	Clay	675	712

CODED

DEPT. OF NATURAL RESOURCES
 BUREAU OF LAND & WATER RESOURCES

JAN 27 1984

RECEIVED

If well telescopes please sketch and show depths.

GROUND LEVEL

Seal AT 273'

500' CASING

121' of BLANK

30' of Screen

20' Screen


Bottom well

712'

If more than one screen, show locations of each on sketch.

772
121
593
40
633
~~273~~
~~500~~
~~20~~
~~30~~
~~712~~

← 20' BLANK
← 42' BLANK

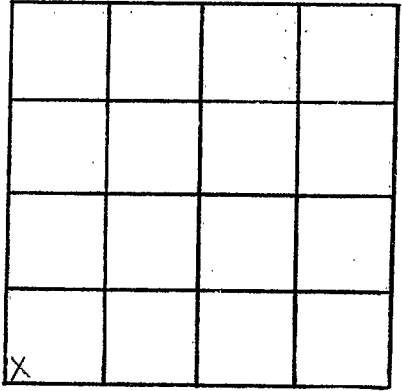

SECTION 3

Please indicate well location X.

ADDITIONAL INFORMATION

Table with 10 horizontal rows for additional information.

712
- 20
692