

MISSISSIPPI DEPARTMENT OF NATURAL RESOURCES

Bureau of Land and Water Resources

Southport Mall

P.O. Box 10631

**CODED**

Jackson, Mississippi 39209

WATER WELL DRILLERS LOG

\$95
SUNFLOWER
4-23-84

April 23, 1984 date well completed      Dyer Well & Irrigation firm name      Sunflower county well located

LANDOWNER: S.N. Good Trust  
 c/o Grenada Bank Trust Dept.  
 Grenada, Miss. 38901  
 (mailing address)

description of formations encountered	from	to
Clay	0	34
fine sand	34	44
Sand	44	56
Sand & Brack	56	113

WELL LOCATION:  
 sec. 22 T 19 N R 3 E  
 3 1/2 miles North of Moorhead  
 (distance) (direction) (nearest town)

WELL PURPOSE: irrigation  
 (home, irrigation, municipal, industrial)

- WELL COMPLETION DATA:
- (1) diameter (inches) 16"
  - (2) total depth (feet) 113'
  - (3) static water level (feet) 26' below top of ground.
  - (4) casing Steel 73' (material), (depth)  
 16" (size) if telescope see back.
  - (5) screen 40' 73' (length), (depth to top)  
 16" Mild Steel (size), (material)
  - (6) pump 600 3,000 (HP), (yield gpm)  
 Electric (type power)
  - (7) electric log No (yes or no)  
 (organization running log)
  - (8) how well bottom plugged Plate

DEPT. OF NATURAL RESOURCES  
 BUREAU OF LAND & WATER RESOURCES


MAY - 4 1984

RECEIVED

DRILLERS REMARKS:

If well telescopes please sketch and show depths.

GROUND LEVEL

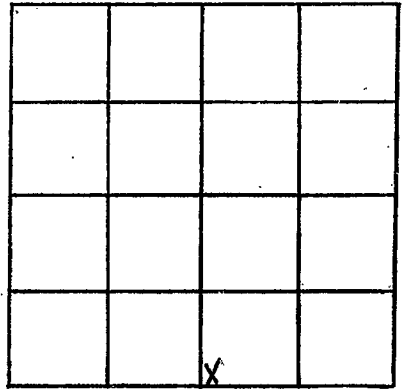

SECTION 22

Please indicate well location X.

ADDITIONAL INFORMATION

If more than one screen, show locations of each on sketch.