

1337
 SUNFLOWER
 97
 RW 163

MISSISSIPPI DEPARTMENT OF NATURAL RESOURCES
 Bureau of Land and Water Resources
 Southport Mall
 P.O. Box 10631
 Jackson, Mississippi 39209
CODED
 WATER WELL DRILLERS LOG

19 1984 date well completed Dyer Well firm name Sunflower county well located

LANDOWNER:
W.F. Austin
Indianola, Miss.
 (mailing address)

description of formations encountered	from	to
<u>Clay</u>	<u>0</u>	<u>35'</u>
<u>Sand + Gravel</u>	<u>35'</u>	<u>110'</u>

WELL LOCATION:
 sec. 13 T. 19 N. R. 3 E
3 miles North of Moorehead
 (distance) (direction) (nearest town)

CODED

WELL PURPOSE: irrigation
 (home, irrigation, municipal, industrial)


- WELL COMPLETION DATA:
- (1) diameter (inches) 16"
 - (2) total depth (feet) 110'
 - (3) static water level (feet) 27' below above top of ground.
 - (4) casing STEEL, 70'
 (material) (depth)
16" If telescope see back.
 (size)
 - (5) screen soft, 70'
 (length) (depth to top)
16", STEEL
 (size) (material)
 - (6) pump 100, 3000
 (HP) (yield gpm)
elec
 (type power)
 - (7) electric log No
 (yes or no)
No
 (organization running log)
 - (8) how well bottom plugged
STEEL PLATE

DEPT. OF NATURAL RESOURCES
 BUREAU OF LAND & WATER RESOURCES
 JUL - 2 1984
RECEIVED

DRILLERS REMARKS:

If well telescopes please sketch and show depths.

GROUND LEVEL

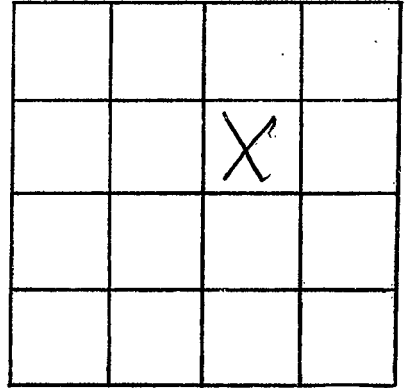

SECTION 13

Please indicate well location X.

ADDITIONAL INFORMATION

If more than one screen, show locations of each on sketch.