

MISSISSIPPI DEPARTMENT OF NATURAL RESOURCES

Bureau of Land and Water Resources

Southport Mall

P.O. Box 10631

Jackson, Mississippi 39209

WATER WELL DRILLERS LOG

CODED

10-3-84
date well completed

1984 J + K Irrigation
firm name

Sunflower
county well located

LANDOWNER:
L.A. Dodd
Sunflower, Miss.
(mailing address)

description of formations encountered	from	to
CLAY	0	22
SAND Gravel	22	113

WELL LOCATION:
sec. 5 T. 19 N. R. 3 E.
S W
3/4 miles E of Sunflower
(distance) (direction) (nearest town)

WELL PURPOSE:
(home, irrigation, municipal, industrial)

CODED

- WELL COMPLETION DATA:
- (1) diameter (inches) 10
 - (2) total depth (feet) 113
 - (3) static water level (feet) 31 below above top of ground.
 - (4) casing PVC 73 (material) (depth)
 - 10 (size) if telescope see back.
 - (5) screen 40 (length) (depth to top)
 - 10 (size) PVC (material)
 - (6) pump 15 (HP) 1000 (yield gpm)
 - electric (type power)
 - (7) electric log NO (yes or no)

(organization running log)

(8) how well bottom plugged cap


DRILLERS REMARKS:

DEPT. OF NATURAL RESOURCES
BUREAU OF LAND & WATER RESOURCES

OCT 16 1984
RECEIVED

If well telescopes please sketch and show depths.

GROUND LEVEL

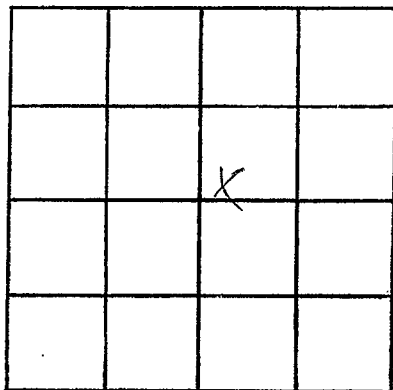

SECTION 5

Please indicate well location X.

ADDITIONAL INFORMATION

If more than one screen,
show locations of each on sketch.