

MISSISSIPPI DEPARTMENT OF NATURAL RESOURCES

Bureau of Land and Water Resources

Southport Mall

P.O. Box 10631

Jackson, Mississippi 39209

WATER WELL DRILLERS LOG

CODED

Sunflower  
099  
10/22/81

10-22  
date well completed

1981

Dyer Well + Irrigation  
firm name

Sunflower  
county well located

LANDOWNER: <u>Charles Fitts</u>	description of formations encountered	from	to
<u>Moorehead, Miss.</u> (mailing address)	<u>Clay</u>	<u>0</u>	<u>33</u>
WELL LOCATION: <u>sec 22 T 19 N S R 3 E W</u>	<u>Sand Sand</u>	<u>33</u>	<u>60</u>
<u>2 1/2</u> miles <u>NW</u> of <u>moorehead</u> (distance) (direction) (nearest town)	<u>Sand + Gravel</u>	<u>60</u>	<u>108</u>
WELL PURPOSE: (home, (irrigation), municipal, industrial)			
WELL COMPLETION DATA:			
(1) diameter (inches) <u>12"</u>			
(2) total depth (feet) <u>108</u>			
(3) static water level (feet) <u>21</u> below above top of ground.			
(4) casing <u>Steel</u> , <u>68</u> (material) (depth)			
<u>12"</u> If telescope see back. (size)			
(5) screen <u>40</u> , <u>68</u> (length) (depth to top)			
<u>12"</u> , <u>Mild Steel</u> (size) (material)			
(6) pump <u>60</u> , <u>3000</u> (HP) (yield gpm)			
<u>Electric</u> (type power)			
(7) electric log <u>No</u> (yes or no)			
<u>None</u> (organization running log)			
(8) how well bottom plugged <u>Plate</u>			
DRILLERS REMARKS:			

DEPT. OF NATURAL RESOURCES  
BUREAU OF LAND & WATER RESOURCES


SEP 30 1982

RECEIVED

4/9/85

If well telescopes please sketch and show depths.

GROUND LEVEL

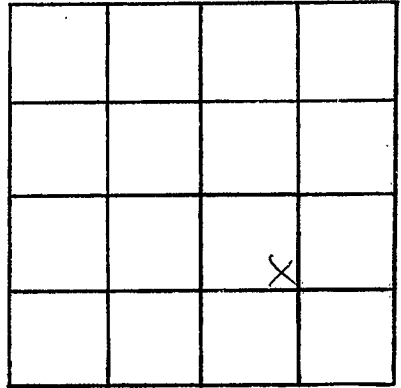

SECTION 22

Please indicate well location X.

ADDITIONAL INFORMATION

If more than one screen,  
show locations of each on sketch.