

SUNFLOWER
 & 100

MISSISSIPPI DEPARTMENT OF NATURAL RESOURCES
 Bureau of Land and Water Resources
 Southport Mall
 P.O. Box 10631
 Jackson, Mississippi 39209
 WATER WELL DRILLERS LOG

CODED

10-2-84
 date well completed

J+K Irrigation
 firm name

Sunflower
 county well located

LANDOWNER:
 L.A. Dodd
 Sunflower, Miss.
 (mailing address)

description of formations encountered	from	to
CLAY	0	22
SAND gravel	22	73

WELL LOCATION:
 sec. 5 T-19 N R-3 E
 1/2 miles E of Sunflower
 (distance) (direction) (nearest town)

WELL PURPOSE:
 (home, irrigation, municipal, industrial)

- WELL COMPLETION DATA:
- (1) diameter (inches) 10
 - (2) total depth (feet) 113
 - (3) static water level (feet) 32 below top of ground.
 - (4) casing PVC, 73 (material), (depth)
 - 10 (size) if telescope see back.
 - (5) screen 40 (length), (depth to top)
 - 10 (size), PVC (material)
 - (6) pump 15 (HP), 1000 (yield gpm)
 - electric (type power)
 - (7) electric log NO (yes or no)

(organization running log)

(8) how well bottom plugged Cap

DRILLERS REMARKS:


CODED

DEPT. OF NATURAL RESOURCES
 BUREAU OF LAND & WATER RESOURCES

OCT 16 1984
 RECEIVED

If well telescopes please sketch and show depths.

GROUND LEVEL

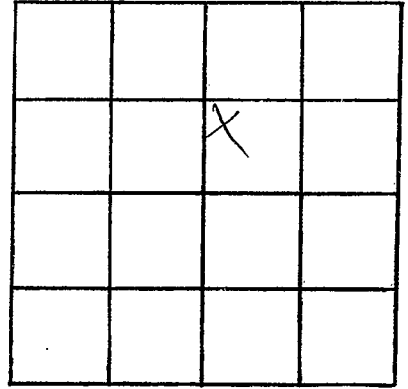

SECTION 5

Please indicate well location X.

ADDITIONAL INFORMATION

If more than one screen,
show locations of each on sketch.