

MISSISSIPPI DEPARTMENT OF NATURAL RESOURCES

Bureau of Land and Water Resources

Southport Mall

P.O. Box 10631

Jackson, Mississippi 39209

WATER WELL DRILLERS LOG

CODED

Sunflower
Ø 102

2-27-86

IRRIGATION Equipment SUNFLOWER

date well completed

firm name

county well located

LANDOWNER: Red Austin
Rt. 2, Box 369
INDIANOLA, MS 38751
887-3878 (mailing address)

description of formations encountered

from

to

<u>Clay</u>	<u>0</u>	<u>30</u>
<u>fine sand</u>	<u>30</u>	<u>40</u>
<u>coarse sand/gravel</u>	<u>40</u>	<u>105</u>

WELL LOCATION:

sec. 13 T. 19 N. R. 3 E
8 miles NE of INDIANOLA
 (distance) (direction) (nearest town)

WELL PURPOSE: Fish Pond
 (home, irrigation, municipal, industrial)

WELL COMPLETION DATA:

- (1) diameter (inches) 16"
- (2) total depth (feet) 105
- (3) static water level (feet) 35' ^{below} _{above} top of ground.
- (4) casing steel 65'
 (material) (depth)
16" if telescope see back.
 (size)
- (5) screen 40' 65'
 (length) (depth to top)
16"
 (size) (material)
- (6) pump 60 3000
 (HP) (yield gpm)
Electric
 (type power)
- (7) electric log NO
 (yes or no)

(organization running log) steel plate

(8) how well bottom plugged

DRILLERS REMARKS:

86029 KSE 03

CODED

RECEIVED


MAR 5 - 1986

Department of Natural Resources
 Bureau of Land & Water Resources

If well telescopes please sketch and show depths.

IRRIGATION EQUIPMENT
COL/867-2555
INDIANOLA, MS

GROUND LEVEL

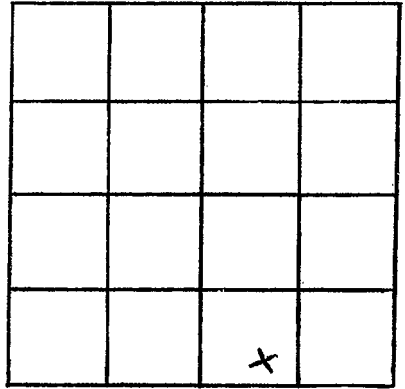

SECTION 13

Please indicate well location X.

ADDITIONAL INFORMATION

If more than one screen,
show locations of each on sketch.