

MISSISSIPPI DEPARTMENT OF NATURAL RESOURCES
Bureau of Land and Water Resources
 Southport Mall
 P.O. Box 10631
 Jackson, Mississippi 39209
WATER WELL DRILLERS LOG

CODED

SUNFLOWER
CD 103

2-26-86 19 IRRIGATION Equipment SUNFLOWER
 date well completed firm name county well located

LANDOWNER: Red Austin
Rt. 2, Box 369
INDIANOLA, MS 38751
887-3878 (mailing address)


description of formations encountered	from	to
<u>Clay</u>	<u>0</u>	<u>35</u>
<u>fine sand</u>	<u>35</u>	<u>45</u>
<u>Coarse sand/peagavel</u>	<u>45</u>	<u>107</u>

WELL LOCATION:
 sec. 13 T 19 N R 3 E
8 miles NE of moorhead
 (distance) (direction) (nearest town)

WELL PURPOSE: Fish Pond
 (home, irrigation, municipal, industrial)

- WELL COMPLETION DATA:**
- diameter (inches) 16"
 - total depth (feet) 107
 - static water level (feet) 35 ^{below} above top of ground.
 - casing steel 67'
 (material) (depth)
16" if telescope see back,
 (size)
 - screen 40' 67'
 (length) (depth to top)
16" steel
 (size) (material)
 - pump 60 3000
 (HP) (yield gpm)
Electric
 (type power)
 - electric log NO
 (yes or no)
 (organization running log) steel plate
 - how well bottom plugged plate

CODED

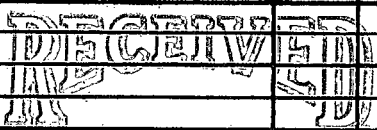


DRILLERS REMARKS:
86029KSE02

Department of Natural Resources
 Bureau of Land & Water Resources

If well telescopes please sketch and show depths.

IRRIGATION EQUIPMENT
601/887-2555
INDIANOLA, MS

GROUND LEVEL

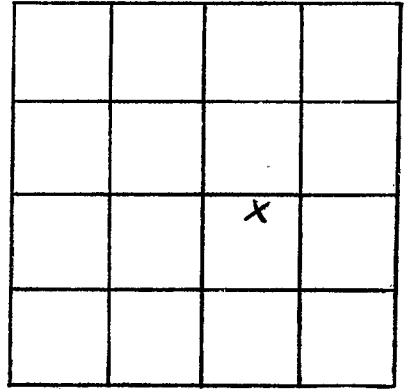

SECTION 13

Please indicate well location X.

ADDITIONAL INFORMATION

If more than one screen,
show locations of each on sketch.