

Sunflower
 #104

MISSISSIPPI DEPARTMENT OF NATURAL RESOURCES
 Bureau of Land and Water Resources
 Southport Mall
 P.O. Box 10631
 Jackson, Mississippi 39209
WATER WELL DRILLERS LOG

CODED

2-24-86
 date well completed

IRRIGATION Equipment
 firm name

SUNFLOWER
 county well located

LANDOWNER: Red Austin
Rt. 2, Box 369
Indianola, MS 38751
887-3878 (mailing address)

| description of formations encountered | from | to |
|---------------------------------------|------|----|
| clay | 0 | 35 |
| fine sand | 35 | 45 |
| coarse sand / pea gravel | 45 | 85 |

WELL LOCATION:
 sec. 13 T 19 N R 3 E
8 miles NE of MOOREHEAD
 (distance) (direction) (nearest town)

CODED

WELL PURPOSE: Rice
 (home, irrigation, municipal, industrial)

WELL COMPLETION DATA:

(1) diameter (inches) 16"

(2) total depth (feet) 85'

(3) static water level (feet) 35 below above top of ground.

(4) casing steel 45'
 (material) (depth)

16" if telescope see back.
 (size)

(5) screen 40' 45'
 (length) (depth to top)

16" steel
 (size) (material)

(6) pump 40 2000
 (HP) (yield gpm)

Diesel
 (type power)

(7) electric log NO
 (yes or no)

(organization running log) steel plate

(8) how well bottom plugged steel plate

RECEIVED

MAR 5 - 1986


DRILLERS REMARKS:
86029 KSEDI

Department of Natural Resources
 Bureau of Land & Water Resources

If well telescopes please sketch and show depths.

IRRIGATION EQUIPMENT
601/887-2555
INDIANOLA, MS

GROUND LEVEL

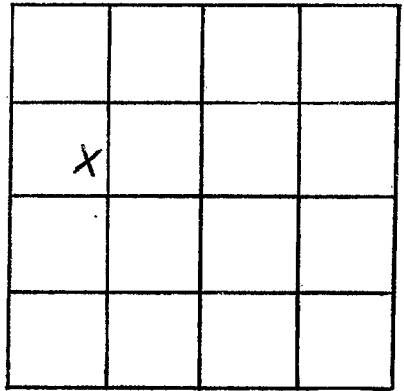

SECTION 13

Please indicate well location X.

ADDITIONAL INFORMATION

If more than one screen,
show locations of each on sketch.