

SUNFLOWER
 #105
 2-24-84

MISSISSIPPI DEPARTMENT OF NATURAL RESOURCES
 Bureau of Land and Water Resources
 Southport Mall
 P.O. Box 10631
 Jackson, Mississippi 39209
WATER WELL DRILLERS LOG

CODED

2-24-86 19 IRRIGATION EQUIPMENT SUNFLOWER
 date well completed firm name county well located

LANDOWNER: W.E. AUSTIN/AUSTIN
FARMS Rt. 2, BOX 369
INDIANOLA, MS 38751
887-3878 (mailing address)

description of formations encountered	from to	
clay	0	35
FINE SAND	35	45
COARSE SAND / PEA GRAVEL	45	85

WELL LOCATION:

sec. 14 T. 19 N. R. 3 E
 S. W. 8 miles NE of Marchessault
 (distance) (direction) (nearest town)

WELL PURPOSE: Rice
 (home, irrigation, municipal, industrial)

WELL COMPLETION DATA:

- (1) diameter (inches) 16"
- (2) total depth (feet) 85'
- (3) static water level (feet) 35 below above top of ground.
- (4) casing steel 45'
 (material) (depth)
16" if telescope see back.
 (size)
- (5) screen 40' 45'
 (length) (depth to top)
16" STEEL
 (size) (material)
- (6) pump 40 2000
 (HP) (yield gpm)
Diesel
 (type power)
- (7) electric log NO
 (yes or no)
 (organization running log) steel plate
- (8) how well bottom plugged steel plate


RECEIVED
 MAR 20 1986

Department of Natural Resources
 Bureau of Land & Water Resources

DRILLERS REMARKS:
 # 86029KSEDI

If well telescopes please sketch and show depths.

GROUND LEVEL

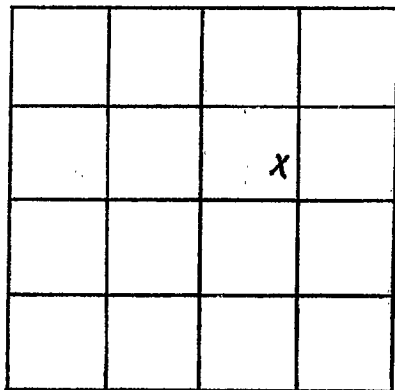

SECTION 14

Please indicate well location X.

ADDITIONAL INFORMATION

If more than one screen,
show locations of each on sketch.