

MISSISSIPPI DEPARTMENT OF NATURAL RESOURCES

Bureau of Land and Water Resources

Southport Mall

P.O. Box 10631

Jackson, Mississippi 39209

WATER WELL DRILLERS LOG

CODED

SUNFLOWER
106
2-26-86

2-26-86

date well completed

19 IRRIGATION EQUIPMENT

firm name

SUNFLOWER

county well located

LANDOWNER: SUNSET PLANTING

COMPANY BOX 1590 INDIANOLA, MS

887-3878

(mailing address)

WELL LOCATION:

sec 13 T 19 N R 3 E
S W
8 miles NE of MOORHEAD
(distance) (direction) (nearest town)

WELL PURPOSE: FISH PONDS
(home, irrigation, municipal, industrial)

WELL COMPLETION DATA:

- (1) diameter (inches) 16"
- (2) total depth (feet) 107'
- (3) static water level (feet) 35 below above
top of ground.
- (4) casing STEEL 67'
(material) (depth)
16" if telescope see back.
(size)
- (5) screen 40' 67'
(length) (depth to top)
16" STEEL
(size) (material)
- (6) pump 60 3000
(HP) (yield gpm)
Electric
(type power)
- (7) electric log NO
(yes or no)
- (organization running log) STEEL
PLATE
- (8) how well bottom plugged

description of formations encountered

from

to

CLAY	0	35
FINE SAND	35	45
COARSE SAND / PEA GRAVEL	45	107

RECEIVED

MAR 20 1986

Department of Natural Resources
Bureau of Land & Water Resources


DRILLERS REMARKS:

#86029KSEO2

If well telescopes please sketch and show depths.

IRRIGATION EQUIPMENT
601/887-2555
INDIANOLA, MS ✓

GROUND LEVEL

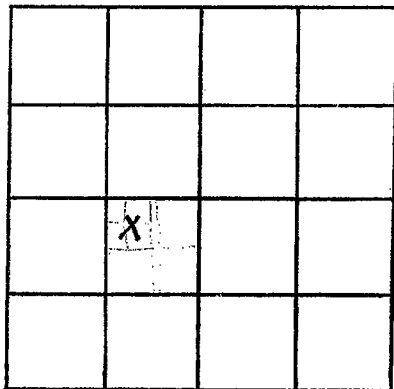

SECTION 13

Please indicate well location X.

ADDITIONAL INFORMATION

If more than one screen,
show locations of each on sketch.