

MISSISSIPPI DEPARTMENT OF NATURAL RESOURCES

Bureau of Land and Water Resources

Southport Mall

P.O. Box 10631

Jackson, Mississippi 39209

WATER WELL DRILLERS LOG

CODED

Sunflower
108
3-18-86

3-18-86
 date well completed

19 Irrigation Equipment
 firm name

SUNFLOWER
 county well located

LANDOWNER: W. E. Austin
Austin Farms Rt. 2, Box 369
Indianola, MS 38751
 (mailing address)

description of formations encountered	from to	
CLAY	0	30
FINE SAND	30	55
COARSE SAND / PEA GRAVEL	55	110

WELL LOCATION:
 sec 32 T 19 N R 3 E
2 miles WEST of MOOREHEAD
 (distance) (direction) (nearest town)

WELL PURPOSE: RICE
 (home, irrigation, municipal, industrial)

- WELL COMPLETION DATA:
- (1) diameter (inches) 16"
 - (2) total depth (feet) 110
 - (3) static water level (feet) 30 below above top of ground.
 - (4) casing STEEL 70'
(material) (depth)
16" If telescope see back.
(size)
 - (5) screen 40' 70'
(length) (depth to top)
16" steel
(size) (material)
 - (6) pump 40 2600
(HP) (yield gpm)
Diesel
(type power)
 - (7) electric log NO
(yes or no)
- (organization running log) STEEL PLATE


DRILLERS REMARKS:
#86 077KSE 04
MS-GW 2407

MAR 20 1986

Department of Natural Resources
 Bureau of Land & Water Resources

If well telescopes please sketch and show depths.

GROUND LEVEL

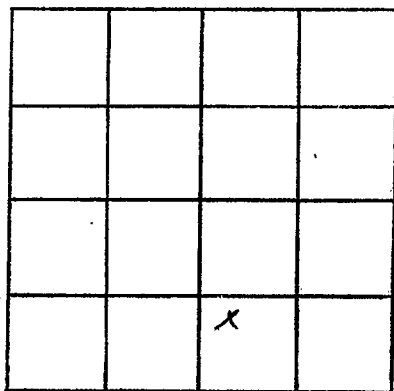

SECTION 32

Please indicate well location X.

ADDITIONAL INFORMATION

If more than one screen,
show locations of each on sketch.