

MISSISSIPPI DEPARTMENT OF NATURAL RESOURCES

Bureau of Land and Water Resources

Southport Mall

P.O. Box 10631

Jackson, Mississippi 39209

WATER WELL DRILLERS LOG

CODED

SUNFLOWER  
 109  
 3-18-86

3-18-86

date well completed

19. IRRIGATION EQUIPMENT

firm name

SUNFLOWER

county well located

LANDOWNER: W.E. AUSTIN

AUSTIN FARMS Rt. 2, BOX 369

INDIANOLA, MS 38751

(mailing address)

description of formations encountered

from

to

CLAY

0

35

FINE SAND

35

60

COARSE SAND / pea gravel

60

105

WELL LOCATION:

sec 32 T19 N R 3 E

2 miles west of Morehead

WELL PURPOSE: Rice

(home, irrigation, municipal, industrial)

WELL COMPLETION DATA:

(1) diameter (inches) 16"

(2) total depth (feet) 105

(3) static water level (feet) 30 below top of ground

(4) casing STEEL 65'

16" (size) If telescope see back.

(5) screen 40 65'

16" (size) STEEL (material)

(6) pump 60 3000

Diesel (type power)

(7) electric log NO (yes or no)

(organization running log)

(8) how well bottom plugged STEEL PLATE

INDEXED  
 MAR 20 1986

Department of Natural Resources  
 Bureau of Land & Water Resources


DRILLERS REMARKS:

# 86077KSE03

MS-GW 2406

If well telescopes please sketch and show depths.

GROUND LEVEL

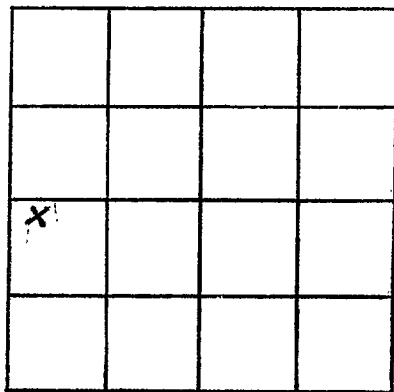

SECTION 32

Please indicate well location X.

ADDITIONAL INFORMATION

If more than one screen, show locations of each on sketch.