

MISSISSIPPI DEPARTMENT OF NATURAL RESOURCES P

Bureau of Land and Water Resources

Southport Mall

P.O. Box 10631

Jackson, Mississippi 39209

WATER WELL DRILLERS LOG

CODED

SUNFLOWER
 #110

April 19, 1985 date well completed
 Larry's Well & Pump firm name
 Sunflower county well located

LANDOWNER: James Holman

description of formations encountered

from

to

	clay	0	24
	Fine sand	24	42
	coarse sand & gravel	42	100

WELL LOCATION:

sec. 26 T. 19 N. R. 3 E.
 3 miles NE of Moorehead
 (distance) (direction) (nearest town)

WELL PURPOSE:


(home, irrigation, municipal, industrial)

WELL COMPLETION DATA:

- (1) diameter (inches) 8"
- (2) total depth (feet) 100'
- (3) static water level (feet) 24' below top of ground.
- (4) casing PUC, 60' (material) (depth)
- (size) If telescope see back.
- (5) screen 40' 60' (length) (depth to top)
- 8" PUC (size) (material)
- (6) pump 20 1000 (HP) (yield gpm)
- Elect (type power)
- (7) electric log No (yes or no)
- (organization running log)
- (8) how well bottom plugged PUC CAP

DRILLERS REMARKS:

CODED

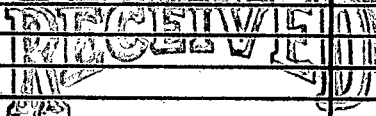


JUN 23 1986

Department of Natural Resources
 Bureau of Land & Water Resources

If well telescopes please
sketch and show depths.

GROUND LEVEL

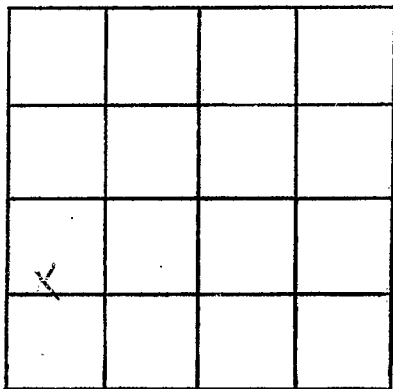

SECTION 26

Please indicate well location X.

ADDITIONAL INFORMATION

If more than one screen,
show locations of each on sketch.