

MISSISSIPPI DEPARTMENT OF NATURAL RESOURCES P

Bureau of Land and Water Resources

Southport Mall

P.O. Box 10631

Jackson, Mississippi 39209

WATER WELL DRILLERS LOG

CODED

SUNFLOWER
Φ111

May 15 1985
date well completed

Larry's well's pump
wll name

Sunflower
county well located

LANDOWNER: I.E. Dattel

description of formations encountered

from

to

clay	0	24
Fine sand	24	50
coarse sand & gravel	50	100

Ruleville ms
(mailing address)

WELL LOCATION:

sec 6 T 19 N R E
S W
2 miles SW of Sunflower
(distance) (direction) (nearest town)

CODED

WELL PURPOSE:

(home, irrigation, municipal, industrial)

WELL COMPLETION DATA:

- (1) diameter (inches) 8"
- (2) total depth (feet) 100'
- (3) static water level (feet) 24' below above top of ground.
- (4) casing PVC 60'
(material) (depth)
(size) if telescope see back.
- (5) screen 40' 60'
(length) (depth to top)
8" PVC
(size) (material)
- (6) pump 10 700
(HP) (yield gpm)
Elect
(type power)
- (7) electric log No.
(yes or no)

(organization running log)

(8) how well bottom plugged PVC cap

RECEIVED


JUN 23 1986

Department of Natural Resources
Bureau of Land & Water Resources

DRILLERS REMARKS:

If well telescopes please
sketch and show depths.

GROUND LEVEL

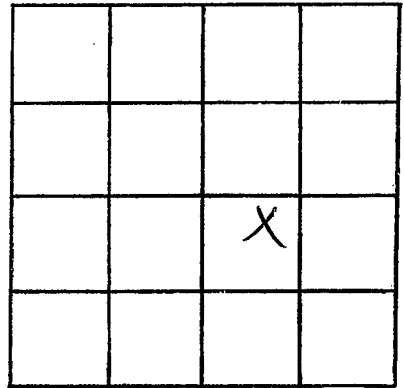

SECTION 6

Please indicate well location X.

ADDITIONAL INFORMATION

If more than one screen,
show locations of each on sketch.