

Bureau of Land and Water Resources

Southport Mall

P.O. Box 10631

Jackson, Mississippi 39209

WATER WELL DRILLERS LOG

CODED

SUNFLOWER
#112

May 15 19 85 date well completed
Lamp's well pump name
Sunflower county well located

LANDOWNER: I.E. Dattel

description of formations encountered

from to

Ruleville ms
(mailing address)

clay	0	26
Fine Sand	26	32
Coarse Sand	32	100

WELL LOCATION:

sec 7 T 19 N R E
S W
2 miles SW of Sunflower
(distance) (direction) (nearest town)


CODED

WELL PURPOSE:

(home, irrigation, municipal, industrial)

WELL COMPLETION DATA:

- (1) diameter (inches) 8"
- (2) total depth (feet) 100'
- (3) static water level (feet) 24' below top of ground.
- (4) casing PVC, 60' (material) (depth)
- (size) If telescope see back.
- (5) screen 40' 60' (length) (depth to top)
- 8" PVC (size) (material)
- (6) pump 10 700 (HP) (yield gpm)
- Elect (type power)
- (7) electric log No (yes or no)

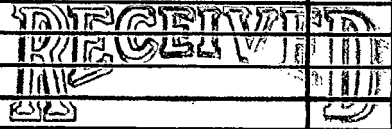

JUN 23 1986

(organization running log)

(8) how well bottom plugged PVC cap

Department of Natural Resources
Bureau of Land and Water Resources

DRILLERS REMARKS:

