

MISSISSIPPI DEPARTMENT OF NATURAL RESOURCES

Bureau of Land and Water Resources

Southport Mall

P.O. Box 10631

Jackson, Mississippi 39209

WATER WELL DRILLERS LOG

CODED

SUNFLOWER  
 114

7-24-86  
 date well completed

IRRIGATION EQUIPMENT  
 firm name

SUNFLOWER  
 county well located

LANDOWNER: Sunset Planting  
Company BOX 1590  
INDIANOLA, MS 38751  
 (mailing address)


description of formations encountered	from	to
CLAY	0	25
FINE SAND	25	45
COARSE SAND/PEA GRAVEL	45	108

WELL LOCATION:  
 sec. 13 T. 19 (N) S R. 3 E W  
8 miles NE of BLAINE  
 (distance) (direction) (nearest town)

WELL PURPOSE: Fish ponds  
 (home, irrigation, municipal, industrial)

- WELL COMPLETION DATA:
- (1) diameter (inches) 16"
  - (2) total depth (feet) 108
  - (3) static water level (feet) 35 below above top of ground.
  - (4) casing steel 68'  
 (material) (depth)  
16"  
 (size) if telescope see back.
  - (5) screen 40 68'  
 (length) (depth to top)  
16" steel  
 (size) (material)
  - (6) pump 600 3000  
 (HP) (yield gpm)  
Electric  
 (type power)
  - (7) electric log NO  
 (yes or no)
  - (8) how well bottom plugged steel plate  
 (organization running log)

CODED

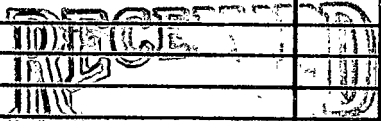

AUG 8 1986

Department of Natural Resources  
 Bureau of Land & Water Resources

DRILLERS REMARKS:  
MSGW02408

If well telescopes please sketch and show depths.

IRRIGATION EQUIPMENT  
601/887-2555  
INDIANOLA, MS

GROUND LEVEL

			x

SECTION 13

Please indicate well location X.

ADDITIONAL INFORMATION

If more than one screen,  
show locations of each on sketch.