

MISSISSIPPI DEPARTMENT OF NATURAL RESOURCES

Bureau of Land and Water Resources

Southport Mall

P.O. Box 10631

Jackson, Mississippi 39209

WATER WELL DRILLERS LOG

SUNFLOWER
 Ⓢ 120
 127 D
 GW 7718

Loaded

~~#9~~ 7-14 19 87 OK Irrigation SUNFLOWER
 date well completed firm name county well located

LANDOWNER: A. B. McCarty
SUNFLOWER, MISS
 (mailing address)

description of formations encountered	from	to
CLAY	0	18
FINE SAND	18	39
COARSE SAND & GRAVEL	39	112

WELL LOCATION:
 sec. 8 T. 19 N. R. 3 E.
 1 1/2 miles S of SUNFLOWER
 (distance) (direction) (nearest town)

WELL PURPOSE: FISH
 (home, irrigation, municipal, industrial)

WELL COMPLETION DATA:

(1) diameter (inches) 10"

(2) total depth (feet) 112

(3) static water level (feet) 28 below/above top of ground.

(4) casing PVC 82
 (material) (depth)
10" if telescope see back.
 (size)

(5) screen 46' 82
 (length) (depth to top)
10" PVC
 (size) (material)

(6) pump 30 1200
 (HP) (yield gpm)
Electric
 (type power)

(7) electric log NO
 (yes or no)
 (organization running log)

(8) how well bottom plugged plate

RECEIVED


NOV 12 1987

Department of Natural Resources
 Bureau of Land & Water Resources

DRILLERS REMARKS:

If well telescopes please sketch and show depths.

GROUND LEVEL

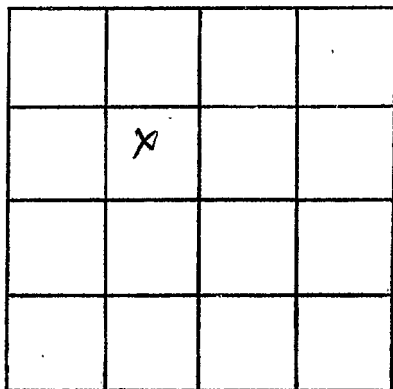

SECTION 8

Please indicate well location X.

ADDITIONAL INFORMATION

If more than one screen,
show locations of each on sketch.