	State Well Report For Office Use Only:		
County: Sunflower		urt 1	•
	Mississippi Department	of Environmental Quality	Aquifer:
Permit #6W 40815		nd Water Resources	Well #: <u>Ø - 179</u>
Irrigation Equipment		ox 10631	•
Driller:1_10_06		S 39289-0631	L. S. Elevation:
Date drilling completed: 1-10-06	1 ' '	61-5210	E-log #:
	j (601)354	-6938 (fax)	E-tog #.
State I aw requires that this ren	ort be prepared by the	driller in detail and filed w	ith the Department within
State Law requires that this report be prepared by the driller in detail and filed with the Department within 30 days of completion of drilling of the well.			
Well Owner Information			Location
Owner Name Tackett Fish Farms		Latitude: 33 ,31 44N	
Mailing Address: 23939 County Road 523		Latitude: 33 31 44N Longitude: 90 27 24.9V Method of Lat/Long (circle one): Conventional Survey,	
visiting routess		USGS quad, Hand-held GPS, Survey-grade GPS	
		SE, NE , Sec 12	Twn 19N Rng3W
Schlater, N	MS 38952		
City Sta	nte Zip Code	Distance Direction	
662-254-732	22	5Miles <u>East</u>	of <u>Sunflower</u>
Telephone No. ()			
	Well I)ata 💮	Pond I64
_			Replacement
Purpose of Well (circle one) Home Inc	dustrial Public Supply	Irrigation Vish Culture	Other
Date well drilling started: $1-10-$	-06 Date v	vell drilling completed:1-	-10-06
If flowing, method of flow regulation: Va	ilveOther (d	escribe)	
Static Water Level: 57 '_feet a	hove of below (circle one) I	and surface Date measured:	1-11-06
Method of Measurement (circle one)	steel tape electric tape	air line other:	
Hole depth: 136 Well de	_{enth:} 136'	Well grouted to a depth of _	10 feet
Wen de		on Progress to a palent or "	
Type of grout (circle one): Cement	Sentonite Mix		
Casing length: 81' feet Casi	ing diameter 16	inches Type of casing:	PVC Sch 40
		_	
<u> </u>	een diameter: 16	inches Type of screen: _	PVC Sch. 40
Screen slot size:	Setting depth: From _	82 feet to 1	36 feet
Type of completion (circle all applicable)	: Gravel packed Under	reamed Telescoped Oper	n hole Natural Development
**************************************	•	• •	-
	Other (describe):		
Top of lap pipe or reduction in casing:	feet. If te	escoped or more than one sci	reen, describe on back of page
- of or my bibe or remaind in smalle.)		,
Logs run (circle all applicable): No log run Electric Gamma Ray Density Sonic Neutron Other:			
Name of organization running log(s):			
I certify that the well was drilled, const			
Department of Environmental Quality	and/or the Mississippi De	partment of Health regulation	ns and state laws.
Irrigation Equip	ment Inc	1) , ,	/

Patrick M. Chism 0695


Print Name of Water Well Contractor and License No.

State Well Report

Ground Level

Description of Formations Encountered	From	To_
Clay	0	21
Clay/fine sand	22	35
Fine Sand	36	45
Fine Sand/gravel Med. Sand/gravel	46	55
Med. Sand/gravel	56	136
		oxdot
		<u> </u>
		L
		$\vdash \vdash \vdash$
		\vdash
		┞──┤
		\vdash
		\vdash
	+-	
		\vdash

If more than one screen, show location of each on sketch

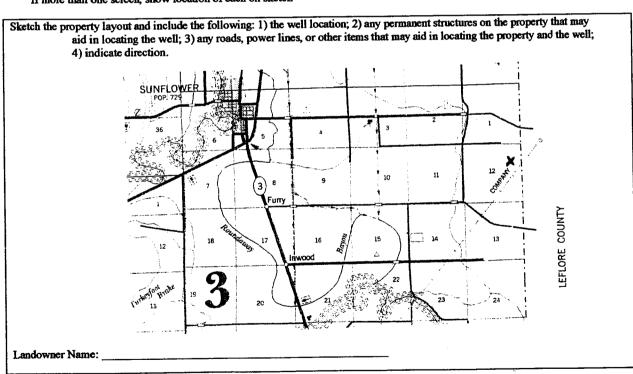

Signature of Water Well Contractor

STATE WELL REPORT

Part 2

Pump Installer's Completion Report
Mississippi Department of Environmental Quality
Office of Land and Water Resources
P.O. Box 10631
Jackson, MS 39289-0631
(601)961-5210
(601)354-6938 (fax)

For Office Use Only:		
Aquifer:		
Well #: <u>Q - 179</u> Elevation:		

This report should be prepared by the pump installer in detail and filed with the Department within 30 days of the installation of pump.

County: Sunflower

Date completed: 1-11-06

Irrigation Equipment

Permit#:

Well Owner Information	Well Location
Owner Name: Tackett Fish Farms	Latitude: Longitude:
Mailing Address: 23939 County Road 523	Method of Lat/Long (circle one): Conventional Survey,
Schlater, MS 38952	USGS quad, Hand-held GPS, Survey-grade GPS SE % NE % Sec 1 2 Twn 19N Rng 3W
City State Zip Code $662-254-7322$ Telephone No. (Distance Direction Nearest Town 5 Miles East of Sunflower

	Pump Ty Circle or			Power Type Circle one	
Air Lift	Jet	Submersible	Diesel Engine	Gasoline Engine	Natural Gas
Bucket	Piston	Turbine	Electric Motor	Hand	Tractor PTO
Centrifugal	Rotary	Flowing Well	Windmill	Other (specify):	
Other (specify):			Horse Power Ratin	ng of Motor: 60	
Date Pump Installed: _	1 –	11-06	Setting Depth:	80	feet
Rated Pump Capacity:	2500	Gallons Per Minute	Number of Stages:	2	·

Pump Test Data	Method of Measuring Water Level Circle one		
Date Well Tested:	Circle one		
Static Water Level (A):Feet Below Land Surface	Air Line Electric Measuring Line Steel Tape		
Pumping Water Level (B):Feet Below Land Surface	Other (specify):		
Drawdown [(B) - (A)]:Feet Below Land Surface	For flowing well, measured shut in head:feet		
Test Pumping Rate:Gallons Per Minute	Well yieldedGPM with a drawdown of		
Duration of Pump Test (minimum 4 hours):hours	feet afterhours of pumping		

I HEREBY CERTIFY that the above statements are true to the be	st of my knowledge,
Patrick M. Chism 0695	Patro M Chin
Print Name of Pump Installer and License No. (if applicable)	Signature of Pump Installer

RECEIVED