
	J State W	ell Report	
County: <u>Sunflower</u>	Part 1 – D	Part 1 – Driller's Log Mississippi Department of Environmental Quality Office of Land and Water Resources P.O. Box 10631	
Permit #:			
3			
Driller: MS. OFFICE OF GEOLOGY	Jackson, MS 39289-0631		L. S. Elevation: 120'
Date drilling completed: 9/3/01		(601)961-5210	
22.24 - 22.27 - 2 2.22.27 - 2	(601)354	l-6938 (fax)	E-log #: 0-0193
State Law requires that this repo	ort be prepared by the lice	ense holder responsible for t	he work and filed with the
Department at the above addres Information on Well	s within 30 days of comp	letion of drilling of the well	or borehole.
(Landowner if borehole is not for a water well)		Well or Borehole Location	
Owner Name Rick Moyer		Latitude: 33 ° 32 , 31	" Longitude: <u>90 ° 27 ' 32 "</u>
Mailing Address: P.O. Box		Method of Lat/Long (circle on	e): Conventional Survey,
		USGS quad, Hand-held	GPS, Survey-grade GPS
Sun flower	<u>MS</u> <u>38778</u> ite Zip Code	<u>Sw 1/4 NE 1/4 Sec. 1</u>	_Twn <u>19N</u> Rng <u>3</u> W
		Distance Direction	Nearest Town
Telephone No. (662) 569 - 37	81	Miles	of <u>Sunflower</u> , MS
	Well / Boreh	ole Data	
Data drilling started 8/10		200 /	11"
Date drilling started: <u>8/9</u> Date dr	rilling completed:3	Hole depth:	Hole diameter: 7. 13
Location of the source of any surface wat Method of dosing and volume of Chlorin	er used for drilling:	pment: 1 cal chlor.	20 Bleach 11500 gale
Logs run (circle all applicable): No log ru	n Electric Gamma Ray	Density Sonic Neutron)ther:
Name of organization running log(s):	MOEQ		
Purpose of borehole (check one): Water W	ell Geotechnical/Geolog	gical Investigation Ground	Source Heat Pump
If drilling is not related	Survey Other (<i>describe</i>) to water well construction,	skip the remainder of this bloc	ck
Purpose of Well (check one): Home I			
			Other:
f a flowing well, method of flow regulatio			
Static Water Level:feet ab	ove or below (circle one) lar	nd surface Date measured:	
Method of Measurement (circle one) st	eel tape electric tape	air line other:	
Vell depth: Well grouted to a dep	pth offeet Type of		
Casing length:feet Casin			
creen length:feet Scree			
	Setting depth: From		1001
creen slot size:inches	Setting depth: From		
creen slot size:inches	Gravel packed Underrea	amed Telescoped Open h	1
	Gravel packed Underrea	amed Telescoped Open h	

SEP 2 9 2008 BY: OLWR

The sketch below only required for water wells

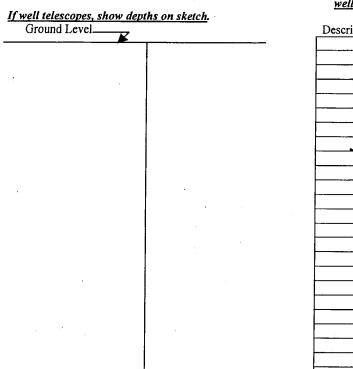

Description of formations encountered must be provided for all					
Description of formations encountered	must be provided	for all			
wells and boreholes, unless specifically	v exempted by regi	<u>ulations</u>			
Description of Formations Encountered	From (depth)	To (depth)			
	Ground Level				
Clay	ð	70			
Sand & Gravel	30	120			
clay	120	130			
Silty	130	220			
Class	220	235			
Silt/clang	235	265			
Sand/clay streaks	265	30.			
· · · · · · · · · · · · · · · · · · ·					
· · · · · · · · · · · · · · · · · · ·					
	· .				
		-			
· · · · · · · · · · · · · · · · · · ·		<u> </u>			
······································	+				
	1				

If more than one screen, show location of each on sketch

Sketch the property layout and include the following: 1) the well location; 2) any permanent structures on the property that may aid in locating the well; 3) any roads, power lines, or other items that may aid in locating the property and the well; 4) a north arrow.

Landowner Name:

Form: OLWR-SWR-1A

I certify that the well/borehole was drilled, constructed, and completed in accordance with all applicable requirements of the Mississippi Department of Environmental Quality and the Mississippi Department of Health regulations, if applicable, and state laws.

ARCHIE MCKENZIE 0-555

9/22/ Date

Print Name of Responsible Licensee and License No.

Signature of Licensee