

MISSISSIPPI DEPARTMENT OF NATURAL RESOURCES

Bureau of Land and Water Resources

Southport Mall

P.O. Box 10631

Jackson, Mississippi 39209

WATER WELL DRILLERS LOG

0200

June 30, 1981  
date well completed

Lanny's well & pump  
firm name

Lincoln  
county well located

LANDOWNER:	description of formations encountered	from	to
Bearden	CLAY	0	22
Isola, MS (mailing address)	SAND	22	80'
WELL LOCATION: sec. 17 T. 19 N R. 3 E	GRAVEL	80'	110'
3 miles S of Southport (distance) (direction) (nearest town)	CLAY	110'	280'
WELL PURPOSE: (home, irrigation, municipal, industrial)	SAND	280	400'
WELL COMPLETION DATA:	CLAY	400'	560'
(1) diameter (inches) 4" x 2"	FINE SAND	560	620
(2) total depth (feet) 700'	COARSE SAND	620	700
(3) static water level (feet) 26' below top of ground.			
(4) casing PVC 120' of 4" (material) (depth) 540' of 2" (size) if telescope see back.			
(5) screen 40' (length), 660' (depth to top) 2" (size), PVC (material)			
(6) pump 1 (HP), 28 (yield gpm) Electric (type power)			
(7) electric log NO (yes or no)			
(organization running log)			
(8) how well bottom plugged SANDS MARK			

DEPT. OF NATURAL RESOURCES  
BUREAU OF LAND & WATER RESOURCES


JAN 8 1982

RECEIVED

DRILLERS REMARKS:

If well telescopes please sketch and show depths.

GROUND LEVEL

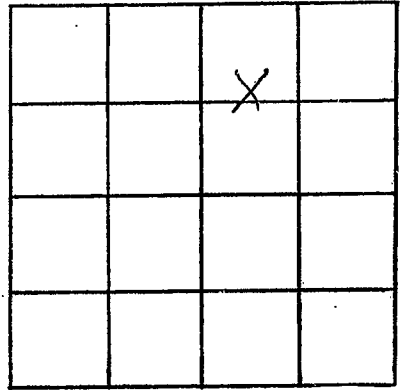

SECTION 17

Please indicate well location X.

ADDITIONAL INFORMATION

If more than one screen,  
show locations of each on sketch.