

MISSISSIPPI DEPARTMENT OF NATURAL RESOURCES

Bureau of Land and Water Resources

127 Do 128c

COUNTY WELL LOCATED <i>Sunflower</i>	
WELL NUMBER <i>Φ</i>	CODED
DATE WELL COMPLETED <i>2003 4-20-89</i>	

PERMIT NUMBER
NAME OF DRILLING FIRM IRRIGATION EQUIPMENT 601/887-2555 INDIANOLA, MS

P.O. Box 10631
Jackson, Mississippi 39209
WATER WELL DRILLERS LOG

NAME & MAILING ADDRESS OF LANDOWNER <i>Milton Adams</i> <i>BOX 244</i> <i>SUNFLOWER</i>			
WELL LOCATION:	SEC <i>21</i>	TOWNSHIP <i>19^N_S</i>	RANGE <i>3^E_W</i>
DISTANCE	DIRECTION	NEAREST TOWN	
<i>3</i> Miles	<i>north</i>	of <i>moorehead</i>	
OTHER LANDMARK			
WELL PURPOSE: Home, Irrigation, Municipal, Industrial, Fish Pond, etc. <i>Fish Pond</i>			

PUMP DATA		
PUMP TYPE (Circle One): <input checked="" type="radio"/> <i>submersible</i> , Turbine, Jet, Flowing Well, Other (Describe)		
POWER TYPE (Circle One): <input checked="" type="radio"/> <i>Electric</i> , Tractor, Diesel, Gasoline, Butane, Other (Describe) H/P <i>40</i>		
Pump Capacity (GPM) <i>1800</i>	No. of Stages <i>1</i>	Setting Depth <i>80</i> FT.
PUMP TEST		
Well yielded _____ GPM with a drawdown of _____ ft. after _____ hours of pumping		

WELL DATA		
Well Depth <i>107'</i>	Casing Diameter (in.) <i>12</i>	Casing Length (Ft.) <i>67</i>
Type of Casing <i>steel</i>	Hole Depth <i>107'</i>	Depth to Static Water Level <i>30'</i>
TYPE OF COMPLETION: (Circle One or More): <input checked="" type="radio"/> <i>Gravel Packed</i> , Underreamed, Telescoped, Natural Development, Open Hole, Other		
Top of Lap Pipe or Reduction in Casing		
FEET <input type="checkbox"/> IF TELESCOPED OR MORE THAN ONE SCREEN: USE BACK PAGE		


LOG DATA	
TYPE OF LOG RUN (Circle One): No Log Run, Electric, Gamma Ray, Density, Sonic, Neutron, Other (Describe)	
Name of Organization Running Log	

SCREEN DATA		
Diameter - Inches <i>12</i>	Length - Feet <i>40</i>	Slot Size - Inches <i>.060</i>
Screen Type <i>Steel</i>		Depth to Bottom - Feet <i>107'</i>

GEOLOGIC DATA (Office Use Only)			
Surface Elev.	Geologic Unit	Unit Thickness	Depth to Top
Subs. SWL	Date	Analysis	Aquifer Test

Driller's Remarks	

DESCRIPTION OF FORMATIONS ENCOUNTERED	FROM	TO
<i>clay</i>	<i>0</i>	<i>15</i>
<i>FINE SAND</i>	<i>15</i>	<i>55</i>
<i>medium SAND</i>	<i>55</i>	<i>70</i>
<i>COARSE SAND + GRAVEL</i>	<i>70</i>	<i>107</i>

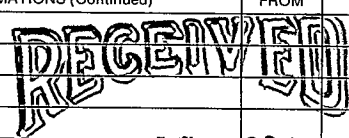FORMATIONS (Continued)	FROM	TO
 APR 27 1989 Department of Natural Resources Bureau of Land & Water Resources		

IF MORE SPACE IS NEEDED, USE BACK

If well telescopes please sketch and show depths.

IRRIGATION EQUIPMENT
601/397-2555
INDIANOLA, MS


GROUND LEVEL

			X

SECTION 21

Please indicate well location X.

ADDITIONAL INFORMATION

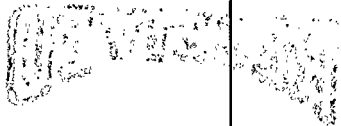

STATE OF MISSISSIPPI DEPARTMENT OF AGRICULTURE
INDIANOLA, MISSISSIPPI 39060

If more than one screen,
show location of each on sketch.