

MISSISSIPPI DEPARTMENT OF ENVIRONMENTAL QUALITY

Office of Land and Water Resources

P. O. Box 10631
Jackson, MS 39289-0631
WATER WELL DRILLERS LOG

COUNTY WELL LOCATED Sunflower	
WELL NUMBER Φ	CODED
DATE WELL COMPLETED 2012 7-13-93	

PERMIT NUMBER
NAME OF DRILLING FIRM IRRIGATION EQUIPMENT
601/887-2555
INDIANOLA, MS

NAME & MAILING ADDRESS OF LANDOWNER Delta Seining			
214 Hwy. 82 E			
INDIANOLA, MS 38751			
WELL LOCATION:	SEC	TOWNSHIP	RANGE
	7	19^S	3^E
DISTANCE	DIRECTION	NEAREST TOWN	
1 Miles	SW	of Sunflower	
OTHER LANDMARK			
WELL PURPOSE: Home, Irrigation, Municipal, Industrial, Fish Pond, etc. Fish Pond			

PUMP DATA		
PUMP TYPE (Circle One): <u>Submersible</u> Turbine, Jet, Flowing Well, Other (Describe) _____		
POWER TYPE (Circle One): <u>Electric</u> Tractor, Diesel, Gasoline, Butane, Other (Describe) _____ H/P 25		
Pump Capacity (GPM)	No. of Stages	Setting Depth
1200	1	60 FT.
PUMP TEST		
Well yielded _____ GPM with a drawdown of _____ ft. after _____ hours of pumping		

WELL DATA		
Well Depth 115	Casing Diameter (In.) 10	Casing Length (Ft.) 75
Type of Casing PVC	Hole Depth 115	Depth to Static Water Level 25'

LOG DATA	
TYPE OF LOG RUN (Circle One): No Log Run, Electric, Gamma Ray, Density, Sonic, Neutron, Other (Describe) _____	
Name of Organization Running Log	

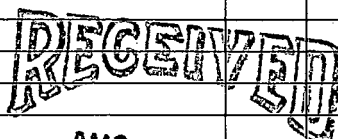
TYPE OF COMPLETION: (Circle One or More):
Gravel Packed, Underreamed, Telescoped,
Natural Development, Open Hole, Other
(Describe) _____

WELL GROUTED TO A DEPTH OF _____ FEET
Type Grout (circle one): Cement, Bentonite, or Mix

GEOLOGIC DATA (Office Use Only)			
Surface Elev.	Geologic Unit	Unit Thickness	Depth to Top
Subs. SWL	Date	Analysis	Aquifer Test

SCREEN DATA		
Diameter - Inches 10	Length - Feet 40	Slot Size - Inches .030
Screen Type PVC	Depth to Bottom - Feet 115	

Driller's Remarks Well Number II

DESCRIPTION OF FORMATIONS ENCOUNTERED	FROM	TO	FORMATIONS (Continued)	FROM	TO
Clay	0	15	 AUG 09 1993 Dept. of Environmental Quality Office of Land & Water Resources		
Coarse Sand	15	40			
Sand + Gravel	40	75			
medium sand	75	100			
Coarse Sand + Gravel	100	115			
			IF MORE SPACE IS NEEDED, USE BACK		

If well telescopes please
sketch and show depths.

GROUND LEVEL

X			

SECTION 7

Please indicate well location X.

ADDITIONAL INFORMATION

If more than one screen,
show location of each on sketch.