

MISSISSIPPI DEPARTMENT OF ENVIRONMENTAL QUALITY

Office of Land and Water Resources

P. O. Box 10631
Jackson, MS 39289-0631
WATER WELL DRILLERS LOG

COUNTY WELL LOCATED <i>Sunflower</i>	
WELL NUMBER <i>02053</i>	CODED
DATE WELL COMPLETED <i>11-3-98</i>	

PERMIT NUMBER
NAME OF DRILLING FIRM IRRIGATION EQUIPMENT
601/887-2555

NAME & MAILING ADDRESS OF LANDOWNER <i>DARRELL Bradshaw</i>			
<i>Rt. 1, Box 183-D</i>			
<i>Sunflower, ms 38778</i>			
WELL LOCATION:	SEC	TOWNSHIP	RANGE
<i>NE/NE</i>	<i>15</i>	<i>19 S</i>	<i>3 W</i>
DISTANCE	DIRECTION		NEAREST TOWN
<i>4</i> Miles	<i>SE</i>		of <i>Sunflower</i>
OTHER LANDMARK			
WELL PURPOSE: Home, Irrigation, Municipal, Industrial, Fish Pond, etc. <i>Irrigation</i>			

PUMP DATA		
PUMP TYPE (Circle One): Submersible, <u>Turbine</u> , Jet, Flowing Well, Other (Describe) _____		
POWER TYPE (Circle One): Electric, Tractor, <u>Diesel</u> , Gasoline, Butane, Other (Describe) _____ H/P <u>60</u>		
Pump Capacity (GPM)	No. of Stages	Setting Depth
<i>3000</i>	<i>1</i>	<i>70</i> FT.
PUMP TEST		
Well yielded _____ GPM with a drawdown of _____ ft. after _____ hours of pumping		

WELL DATA		
Well Depth <i>120</i>	Casing Diameter (In.) <i>16</i>	Casing Length (Ft.) <i>80</i>
Type of Casing <i>Pvc</i>	Hole Depth <i>120</i>	Depth to Static Water Level <i>50 ft.</i>
TYPE OF COMPLETION: (Circle One or More): <u>Gravel Pack</u> , Underreamed, Telescoped, Natural Development, Open Hole, Other (Describe) _____		
WELL GROUTED TO A DEPTH OF _____ FEET Type Grout (circle one): Cement, Bentonite, or Mix		

LOG DATA	
TYPE OF LOG RUN (Circle One): No Log Run, Electric, Gamma Ray, Density, Sonic, Neutron, Other (Describe) _____	
Name of Organization Running Log	

SCREEN DATA		
Diameter - Inches <i>16</i>	Length - Feet <i>40</i>	Slot Size - Inches <i>.050</i>
Screen Type <i>Pvc</i>	Depth to Bottom - Feet <i>120</i>	

GEOLOGIC DATA (Office Use Only)			
Surface Elev.	Geologic Unit	Unit Thickness	Depth to Top
Subs. SWL	Date	Analysis	Aquifer Test
Driller's Remarks			
Top of Lap Pipe or Reduction in Casing			
FEET	IF TELESCOPED OR MORE THAN ONE SCREEN: USE BACK PAGE		

DESCRIPTION OF FORMATIONS ENCOUNTERED	FROM	TO
<i>Clay</i>	<i>0</i>	<i>15</i>
<i>Fine SAND</i>	<i>15</i>	<i>30</i>
<i>med. SAND</i>	<i>30</i>	<i>60</i>
<i>Fine SAND</i>	<i>60</i>	<i>70</i>
<i>med. SAND</i>	<i>70</i>	<i>105</i>
<i>COARSE SAND + GRAVEL</i>	<i>105</i>	<i>120</i>

FORMATIONS (Continued)	FROM	TO
RECEIVED		
MAR 29 1999		
Mississippi Department of Environmental Quality Office of Land & Water Resources		
IF MORE SPACE IS NEEDED, USE BACK		

If well telescopes please sketch and show depths.


GROUND LEVEL

			X

SECTION 15

Please indicate well location X.

ADDITIONAL INFORMATION

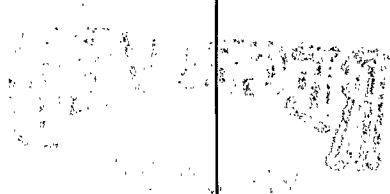

If more than one screen,
show location of each on sketch.