

SUNFLOWER
 Ø 2058
 10-3-77

MISSISSIPPI
 BOARD OF WATER COMMISSIONERS
 416 North State Street
 Jackson, Mississippi 39201

15H

WATER WELL DRILLERS LOG

BUTANE GAS COMPANY
 OF GREENWOOD

Sunflower
 county well located

10/3/77
 date well completed 19

LANDOWNER:
 A. J. Riley
 Sunflower
 (mailing address)

description of formations encountered	from	to
Clay	0	40
Sand	40	80
Sand & Gravel	80	120

WELL LOCATION:
 sec. 8 T. 19 N R. 9 E
 1/2 miles SE of Sunflower
 (distance) (direction) (nearest town)

WELL PURPOSE: Home
 (home, irrigation, municipal, industrial)

WELL COMPLETION DATA:

(1) diameter (inches) 4"

(2) total depth (feet) 120

(3) static water level (feet) 25 below top of ground.

(4) casing PVC, 100 (material), (depth)
 4" (size) if telescope see back.

(5) screen 20, 100 (length), (depth to top)
 4" (size), PVC (material)

(6) pump 1/3 (HP), 60 (yield gpm)

Elec- (type power)

(7) electric log NO (yes or no)

(organization running log)

(8) how well bottom plugged
 Back Pressure Valve


DRILLERS REMARKS:

RECEIVED
 OCT 11 1977

MISS. BD.

If well telescopes please sketch and show depths.

GROUND LEVEL

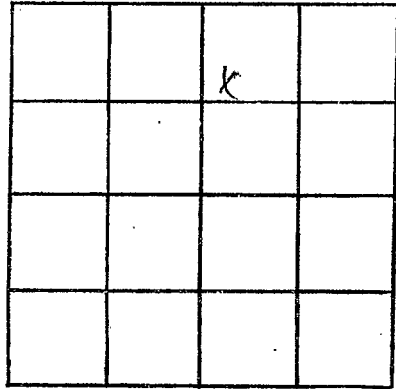

SECTION 8

Please indicate well location X.

ADDITIONAL INFORMATION

If more than one screen,
show locations of each on sketch.