

MISSISSIPPI DEPARTMENT OF NATURAL RESOURCES

Bureau of Land and Water Resources

Southport Mall

P.O. Box 10631

Jackson, Mississippi 39209

BUTANE GAS WATER WELL DRILLERS LOG

POST OFFICE BOX 1135

GREENWOOD, MISS. 38930 county well located

Sunflower

Ø 2060

4-14-83 date well completed

Sunflower

LANDOWNER:

William Tackett

(mailing address)

description of formations encountered

from to

Clay	0	25
Sand	25	45
Sand & gravel	45	93

WELL LOCATION:

sec. 1 T. 19 N R. 3 E S. (W) 4.5 miles E. of Sunflower (distance) (direction) (nearest town)

WELL PURPOSE: Irrigation (home, irrigation, municipal, industrial)

WELL COMPLETION DATA:

- (1) diameter (inches) 16"
- (2) total depth (feet) 93
- (3) static water level (feet) 14 below top of ground.
- (4) casing steel, 53 (material), (depth) 16" (size) if telescope see back.
- (5) screen 40' (length), 53 (depth to top) 16" (size), steel (material)
- (6) pump 60 (HP), 2500 (yield gpm) Diesel (type power)
- (7) electric log No (yes or no) NO (organization running log)
- (8) how well bottom plugged ~~plug~~ No steel plate

DEPT. OF NATURAL RESOURCES BUREAU OF LAND & WATER RESOURCES

MAY 6 - 1983


RECEIVED

DRILLERS REMARKS:

Charles Rimmer

If well telescopes please sketch and show depths.

GROUND LEVEL

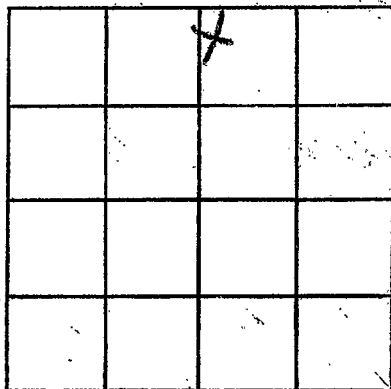

SECTION 1

Please indicate well location X.

ADDITIONAL INFORMATION

If more than one screen,
show locations of each on sketch.