

MISSISSIPPI DEPARTMENT OF NATURAL RESOURCES

Bureau of Land and Water Resources

Southport Mall

P.O. Box 10631

Jackson, Mississippi 39209

WATER WELL DRILLERS LOG

SUNFLOWER
CD 2062

12-12 1985 J & K Tr. Ser. SUNFLOWER
 date well completed firm name county well located

LANDOWNER: A. B. McCarty

description of formations encountered	from	to
<u>CLAY</u>	<u>0</u>	<u>35</u>
<u>FINE SAND</u>	<u>35</u>	<u>49</u>
<u>SAND & GRAVEL</u>	<u>49</u>	<u>117</u>

SUNFLOWER

(mailing address)

WELL LOCATION:
 sec. 17 T. 19 N. R. 3 E
2 miles NW of SUNFLOWER
 (distance) (direction) (nearest town)

WELL PURPOSE: IRIGATION
 (home, irrigation, municipal, industrial)


WELL COMPLETION DATA:

- (1) diameter (inches) 16"
- (2) total depth (feet) 114"
- (3) static water level (feet) 19 below above top of ground.
- (4) casing Steel 74
 (material) (depth)
16 if telescope see back.
 (size)
- (5) screen 40 74
 (length) (depth to top)
16" Steel
 (size) (material)
- (6) pump 40 2000
 (HP) (yield gpm)
Electric
 (type power)
- (7) electric log NO
 (yes or no)

(organization running log)

(8) how well bottom plugged PLATE


DRILLERS REMARKS:

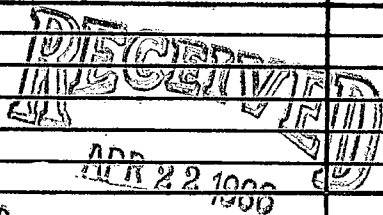

Department of Natural Resources
 Bureau of Land & Water Resources

If well telescopes please sketch and show depths.

GROUND LEVEL

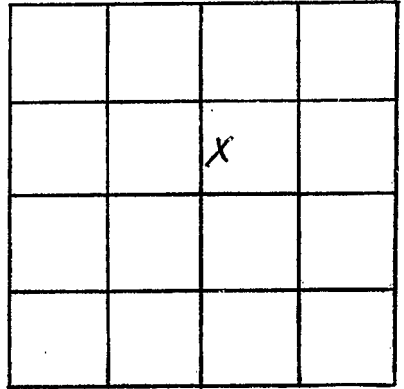

SECTION 12

Please indicate well location X.

ADDITIONAL INFORMATION

If more than one screen,
show locations of each on sketch.