

MISSISSIPPI DEPARTMENT OF NATURAL RESOURCES

Bureau of Land and Water Resources

Southport Mall

P.O. Box 10631

Jackson, Mississippi 39209

WATER WELL DRILLERS LOG

SUNFLOWER
 2064

12-12 1985 J & K Irrigation Sunflower
 date well completed firm name county well located

LANDOWNER: A. B. McCarty
 Sunflower
 (mailing address)

description of formations encountered	from	to
CLAY	0	35
FINE SAND	35	49
GRAVEL SAND	49	117

WELL LOCATION:
 sec 17 T 19 N R 3 E
 S W
 2 miles NW of Sunflower
 (distance) (direction) (nearest town)

WELL PURPOSE: IRRIGATION
 (home, irrigation, municipal, industrial)

- WELL COMPLETION DATA:
- (1) diameter (inches) 16
 - (2) total depth (feet) 116
 - (3) static water level (feet) 19 below top of ground.
 - (4) casing Steel 76 (material) (depth)
 - 16 (size) if telescope see back.
 - (5) screen 40 76 (length) (depth to top)
 - 16 Steel (size) (material)
 - (6) pump 40 2000 (HP) (yield gpm)
 - Eletic (type power)
 - (7) electric log NO (yes or no)
 - (organization running log)
 - (8) how well bottom plugged PLATE


DRILLERS REMARKS:

RECEIVED
 APR 22 1986
 SUNFLOWER

Department of Natural Resources
 Bureau of Land & Water Resources

If well telescopes please sketch and show depths.

GROUND LEVEL

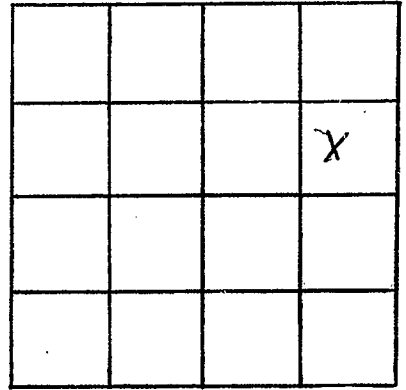

SECTION 17

Please indicate well location X.

ADDITIONAL INFORMATION

If more than one screen,
show locations of each on sketch.