

MISSISSIPPI DEPARTMENT OF NATURAL RESOURCES

Bureau of Land and Water Resources

Southport Mall

P.O. Box 10631

Jackson, Mississippi 39209

WATER WELL DRILLERS LOG

SUNFLOWER
 (D) 2065

12/2/85
 date well completed

J & K Irrigation
 firm name

SUNFLOWER
 county well located


LANDOWNER: A. B. McCarty
SUNFLOWER
 (mailing address)

description of formations encountered	from	to
CLAY	0	34
FINE SAND	34	51
GRAVEL SAND	51	108

WELL LOCATION:
 sec. 30 T. 19 N. R. 3 ^W
5 miles NE of Indiola
 (distance) (direction) (nearest town)

WELL PURPOSE: Irrigation
 (home, irrigation, municipal, industrial)

- WELL COMPLETION DATA:
- (1) diameter (inches) 16"
 - (2) total depth (feet) 116
 - (3) static water level (feet) 18 ^{below} ~~above~~ top of ground.
 - (4) casing Steel (76 depth), 16" (size) if telescope see back.
 - (5) screen 40 (76 length), Steel (76 depth to top), 16" (size), Steel (material)
 - (6) pump 40 (2000 HP), 2000 (yield gpm), Diesel (type power)
 - (7) electric log NO (yes or no)
 (organization running log)
 - (8) how well bottom plugged PLATE

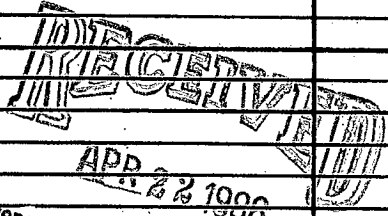


Department of Natural Resources
 Bureau of Land & Water Resources

DRILLERS REMARKS:

If well telescopes please
sketch and show depths.

GROUND LEVEL

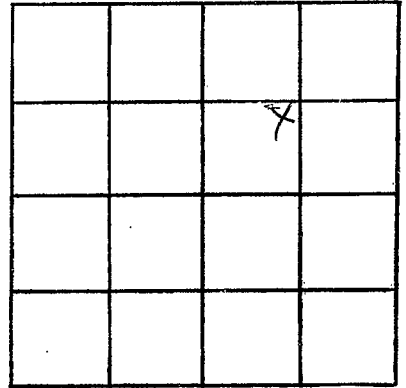

SECTION 30

Please indicate well location X.

ADDITIONAL INFORMATION

If more than one screen,
show locations of each on sketch.