

MISSISSIPPI DEPARTMENT OF NATURAL RESOURCES

Bureau of Land and Water Resources

P.O. Box 10631

Jackson, Mississippi 39209

WATER WELL DRILLERS LOG

COUNTY WELL LOCATED Sunflower	
WELL NUMBER Φ2068	CODED
DATE WELL COMPLETED 8-25-89	

14713

PERMIT NUMBER
NAME OF DRILLING FIRM IRRIGATION EQUIPMENT
601/887-2555
INDIANOLA, MS

NAME & MAILING ADDRESS OF LANDOWNER Allen Holdeman		
Pond AVE.		
INVERNESS, MS		
WELL LOCATION: SEC	TOWNSHIP	RANGE
31	19	3
DISTANCE DIRECTION NEAREST TOWN		
2 Miles	west	of Moorhead
OTHER LANDMARK		
WELL PURPOSE: Home, Irrigation, Municipal, Industrial, Fish Pond, etc. Fish Pond		

PUMP DATA		
PUMP TYPE (Circle One): <u>Submersible</u> Turbine, Jet, Flowing Well, Other (Describe) _____		
POWER TYPE (Circle One): <u>Electric</u> Tractor, Diesel, Gasoline, Butane, Other (Describe) _____ H/P <u>20</u>		
Pump Capacity (GPM)	No. of Stages	Setting Depth
1000	1	60 FT.
PUMP TEST		
Well yielded _____ GPM with a drawdown of _____ ft. after _____ hours of pumping		

WELL DATA		
Well Depth 115'	Casing Diameter (In.) 10	Casing Length (Ft.) 75
Type of Casing Steel	Hole Depth 115'	Depth to Static Water Level 32'
TYPE OF COMPLETION: (Circle One or More): <u>Gravel Packed</u> Underreamed, Telescoped, Natural Development, Open Hole, Other		
Top of Lap Pipe or Reduction in Casing		
FEET	IF TELESCOPED OR MORE THAN ONE SCREEN: USE BACK PAGE	

LOG DATA	
TYPE OF LOG RUN (Circle One): No Log Run, Electric, Gamma Ray, Density, Sonic, Neutron, Other (Describe) _____	
Name of Organization Running Log	

SCREEN DATA		
Diameter - Inches 10	Length - Feet 40	Slot Size - Inches .060
Screen Type steel	Depth to Bottom - Feet 115	

GEOLOGIC DATA (Office Use Only)			
Surface Elev.	Geologic Unit	Unit Thickness	Depth to Top
Subs. SWL	Date	Analysis	Aquifer Test

Driller's Remarks

RECEIVED

DESCRIPTION OF FORMATIONS ENCOUNTERED	FROM	TO
Clay	0	15
medium sand	15	55
COARSE SAND	55	80
COARSE SAND + GRAVEL	80	115

FORMATIONS (Continued)	FROM	TO
AUG 29 1989		
Department of Natural Resources Bureau of Land & Water Resources		

IF MORE SPACE IS NEEDED, USE BACK

If well telescopes please sketch and show depths.

IRRIGATION EQUIPMENT
601/887-2555
INDIANOLA, MS


GROUND LEVEL

			X

SECTION 31

Please indicate well location X.

ADDITIONAL INFORMATION

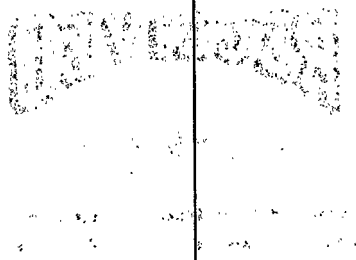

If more than one screen,
show location of each on sketch.