

SUNFLOWER
P4
6-24-71

MISSISSIPPI
BOARD OF WATER COMMISSIONERS
416 North State Street
Jackson, Mississippi 39201

WATER WELL DRILLERS LOG
DYER WELL & IRRIGATION SERVICE
firm name
SUNFLOWER
county well located

CODED

6/24/71 19
date well completed

LANDOWNER:

Billups Pct. Inc.

description of formations encountered

from

to

CLAY	0	33
SAND & CLAY	33	40
CLAY	50	55
SAND & GRAVEL	55	100

INDIANOLA, MISS.
(mailing address)

WELL LOCATION:

sec. 11 T. 18 N R. 5 E
2 miles S.E. of HEATHMAN
(distance) (direction) (nearest town)

WELL PURPOSE:

TRR.
(home, irrigation, municipal, industrial)

WELL COMPLETION DATA:

- (1) diameter (inches) 16"
- (2) total depth (feet) 100 FT
- (3) static water level (feet) 17' below above top of ground.
- (4) casing BUR. IR. 60 FT (material) (depth)
16" (size) if telescope see back.
- (5) screen 40' 60 FT (length) (depth to top)
16" BUR INGOT (size) (material)
- (6) pump 55 2000 (HP) (yield gpm)
PUTANE (type power)
- (7) electric log No (yes or no)

CODED

(organization running log)

(8) how well bottom plugged PLATE


OCT 26 1971

DRILLERS REMARKS:

MISS. BD. OF
WATER COMM.

If well telescopes please sketch and show depths.

GROUND LEVEL

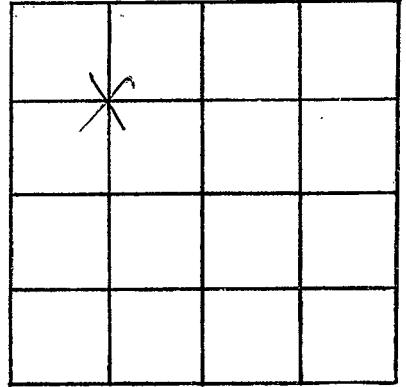

SECTION 11

Please indicate well location X.

ADDITIONAL INFORMATION

If more than one screen,
show locations of each on sketch.